
Plat Book SS, Page 1 5 5 B

REF: PLAT OF INDIAN HILLS FILED IN PLAT BOOK 'QQ' - PAGE II

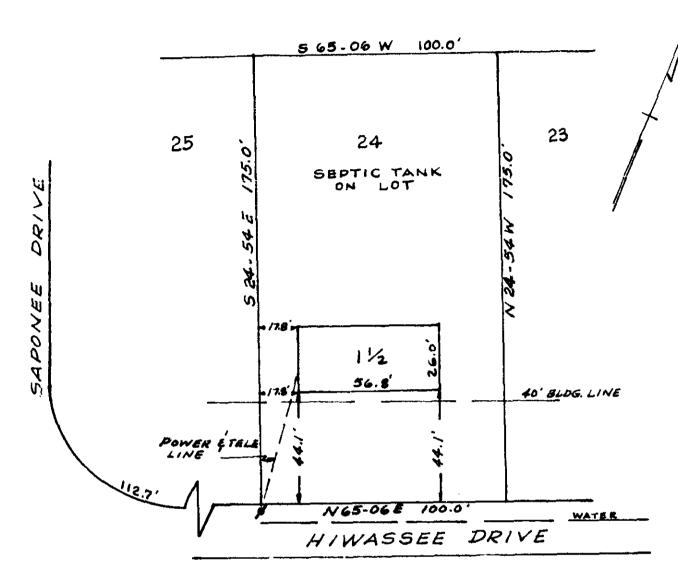

PROPERTY

OF

JAMES H. BOLDING

GREENVILLE , S.C.

SCALE 1" = 40' 13 MAY, 1959

This is to certify that on the 13th day of May, 1959, I surveyed the property shows on this plat; and that the property lines, walls and buildings are as shown hereon; that the buildings located on said lot do not encreach or project on adjacent streets or property; and that no adjacent walls or buildings encreach or project on this lot; and that there are no utility lines crossing this property except as shown.

MAY 15 1959

Registered Engineer No. 962

80220

PIEDMONT ENGINEERING SERVICE GREENVILLE, S. C.

and Recorded in Vol.

