

Plat Book SS. Page 159B


Book SS at Page 159

MAY 20 1959

GREENVILLE CO. S. C.

MAY 20 4 07 PM 1959

PROPERTY OF
JOHN F. BERRYHILL
 AND
ETHEL B. BERRYHILL
 O'NEAL TWP. GREENVILLE, CO.
 SOUTH CAROLINA
 MAY 16, 1959 SCALE 1"=50'

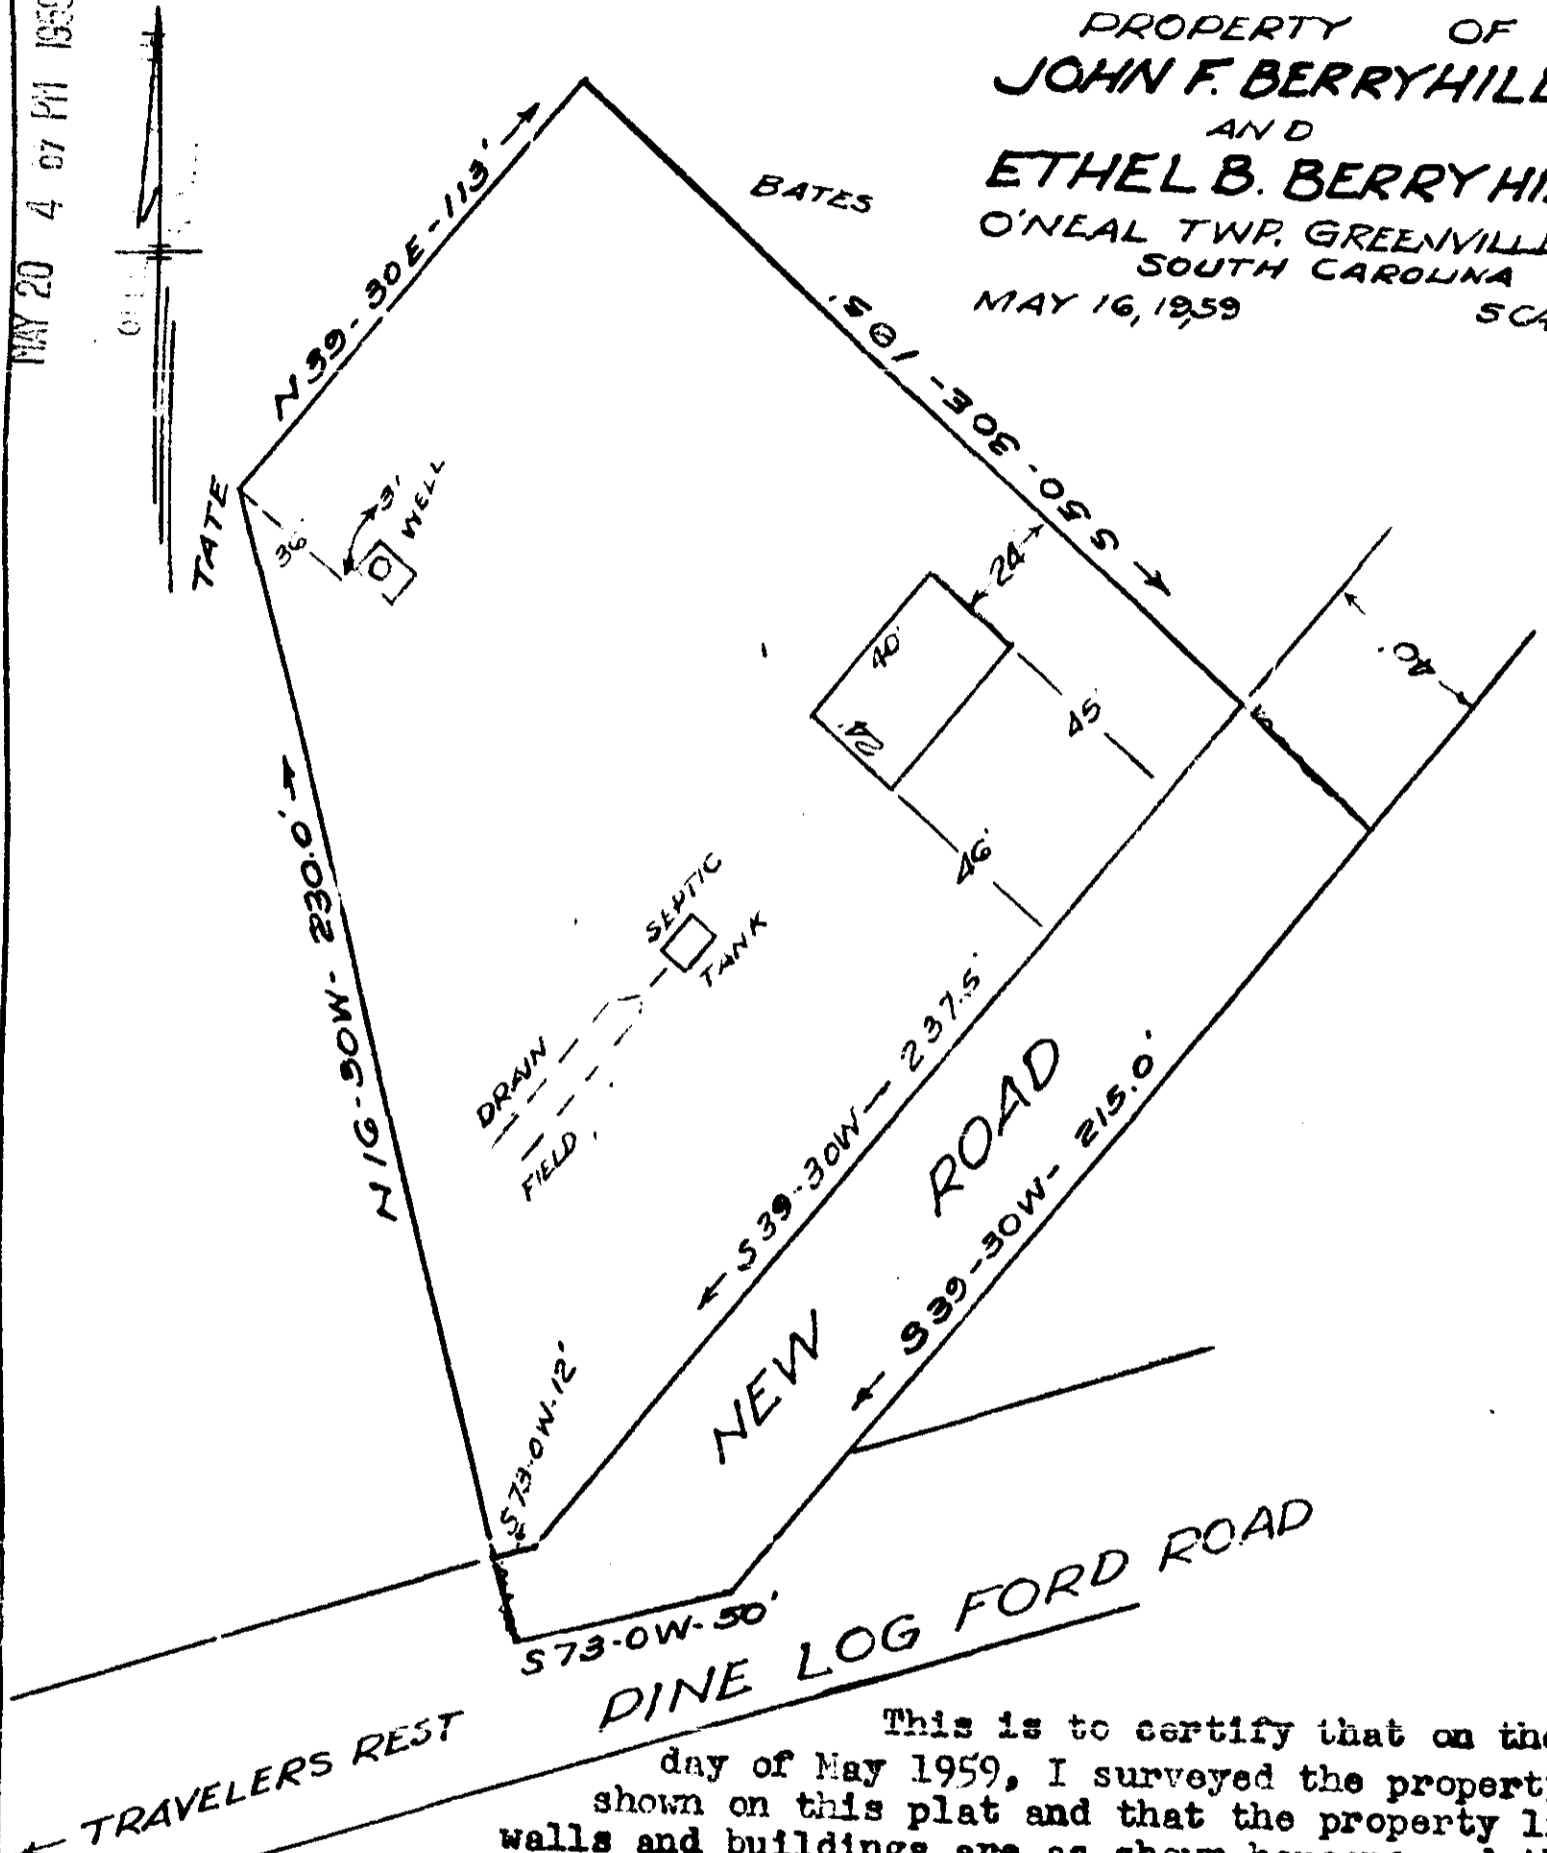

This is to certify that on the 16th day of May 1959, I surveyed the property shown on this plat and that the property lines, walls and buildings are as shown hereon; and that there are no projections or encroachments other than shown.

MAY 20 1959
 30765

T. C. Adams
 T. C. Adams
 Reg. Engineer No. 207

30765 Filed This 20 day of May 1959
 and Recorded in Vol. 2 Page 159B
 Register of Deeds Greenville Co. S. C.