
Plat Book SS, Page 167 B

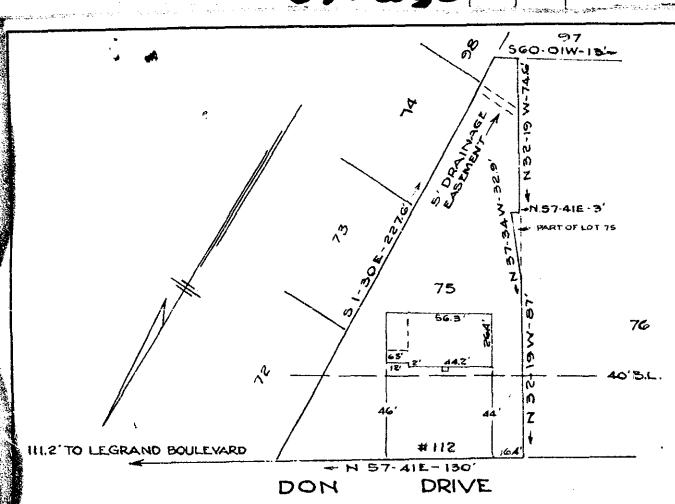

PROPERTY OF
ALBERT W. TIMMONS AND MADA W. TIMMONS
GREENVILLE, S.C.
SCALE 1'-50' JAN. G, 1956.

This is to certify that on the 6th day of January, 1956 I surveyed the property shown on this plat being known as the greater portion of lot no. 75 on plat of Sherwood Forest by Dalton & Neves, Engineers, dated August 1951, revised through June, 1953 and recorded in Plat Book GG at Pages 2 and 3, Office of the R.M.C., Greenville County, S.C. and that the property lines, walls and buildings are as shown hereon; and that the buildings located on the said lot do not encroach or project on adjacent streets or property; and that no adjacent buildings or walls encroach or project on said premises.

PATVICIA C. HALL

JUN 4 1959

32434

J. C. Adama

T. C. Adams
Reg. Engineer # 307




b . #