
Plat Book SS. Page 1

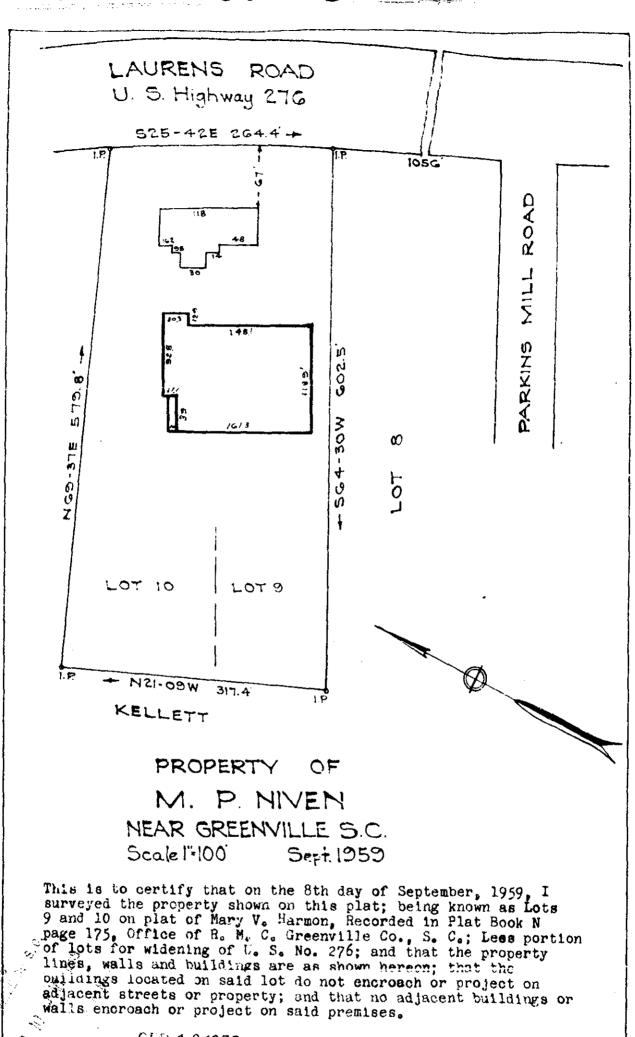

SEP 101959 7992

B.W. Detto

Dalton & Neves, Engineers.

