


Plat Book TT, Page 32

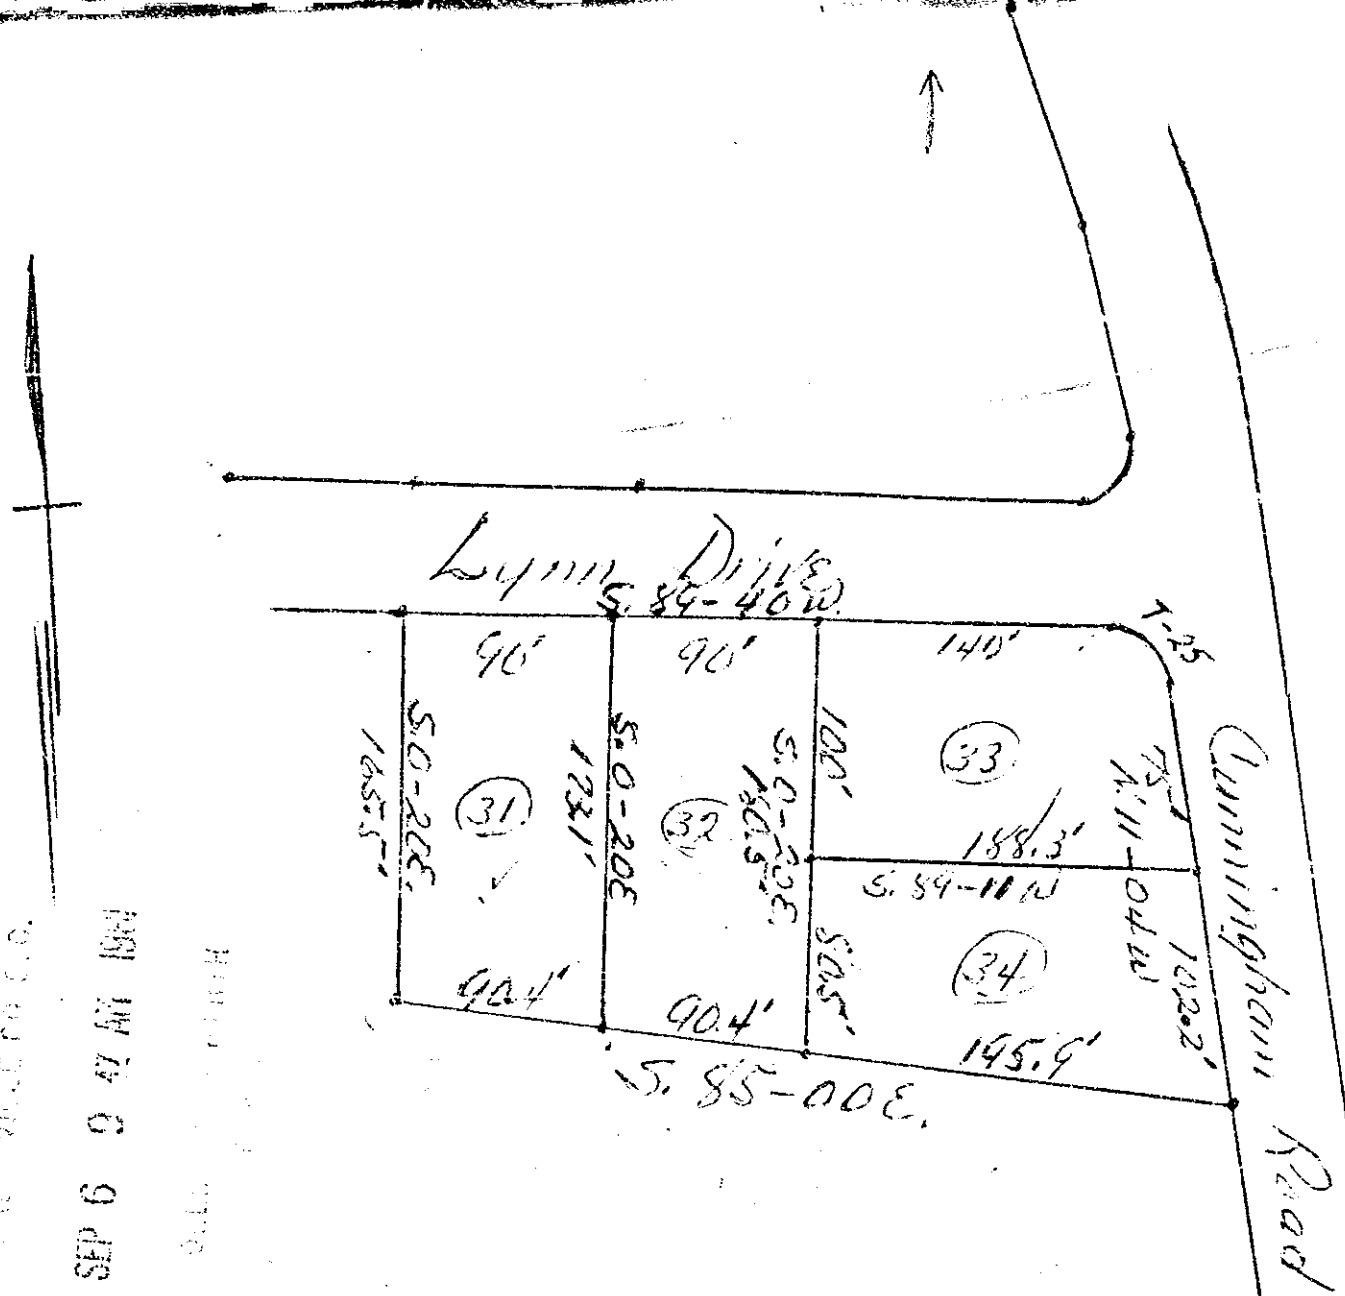

SEP 6 1961
 PART 147 74 9 JES

Rosewood Park, Taylor, S.C.

SEP 6 1961
 6198

Above 4 Lots Revised - Sept. 5, 1961

This Change is to become a part of the
 Rosewood Plat-Revised No. 19, 1959 and Recorded
 R.M.C. Office - Book Page 31-32 574

6198 Filed This 6 Nov. 19 61
 And Recorded in Vol. T. P. 32
 Eddie Sanson
 Register - Deeds Conveyance Co. County, S.C.