


# Plat Book T.T. Page 67

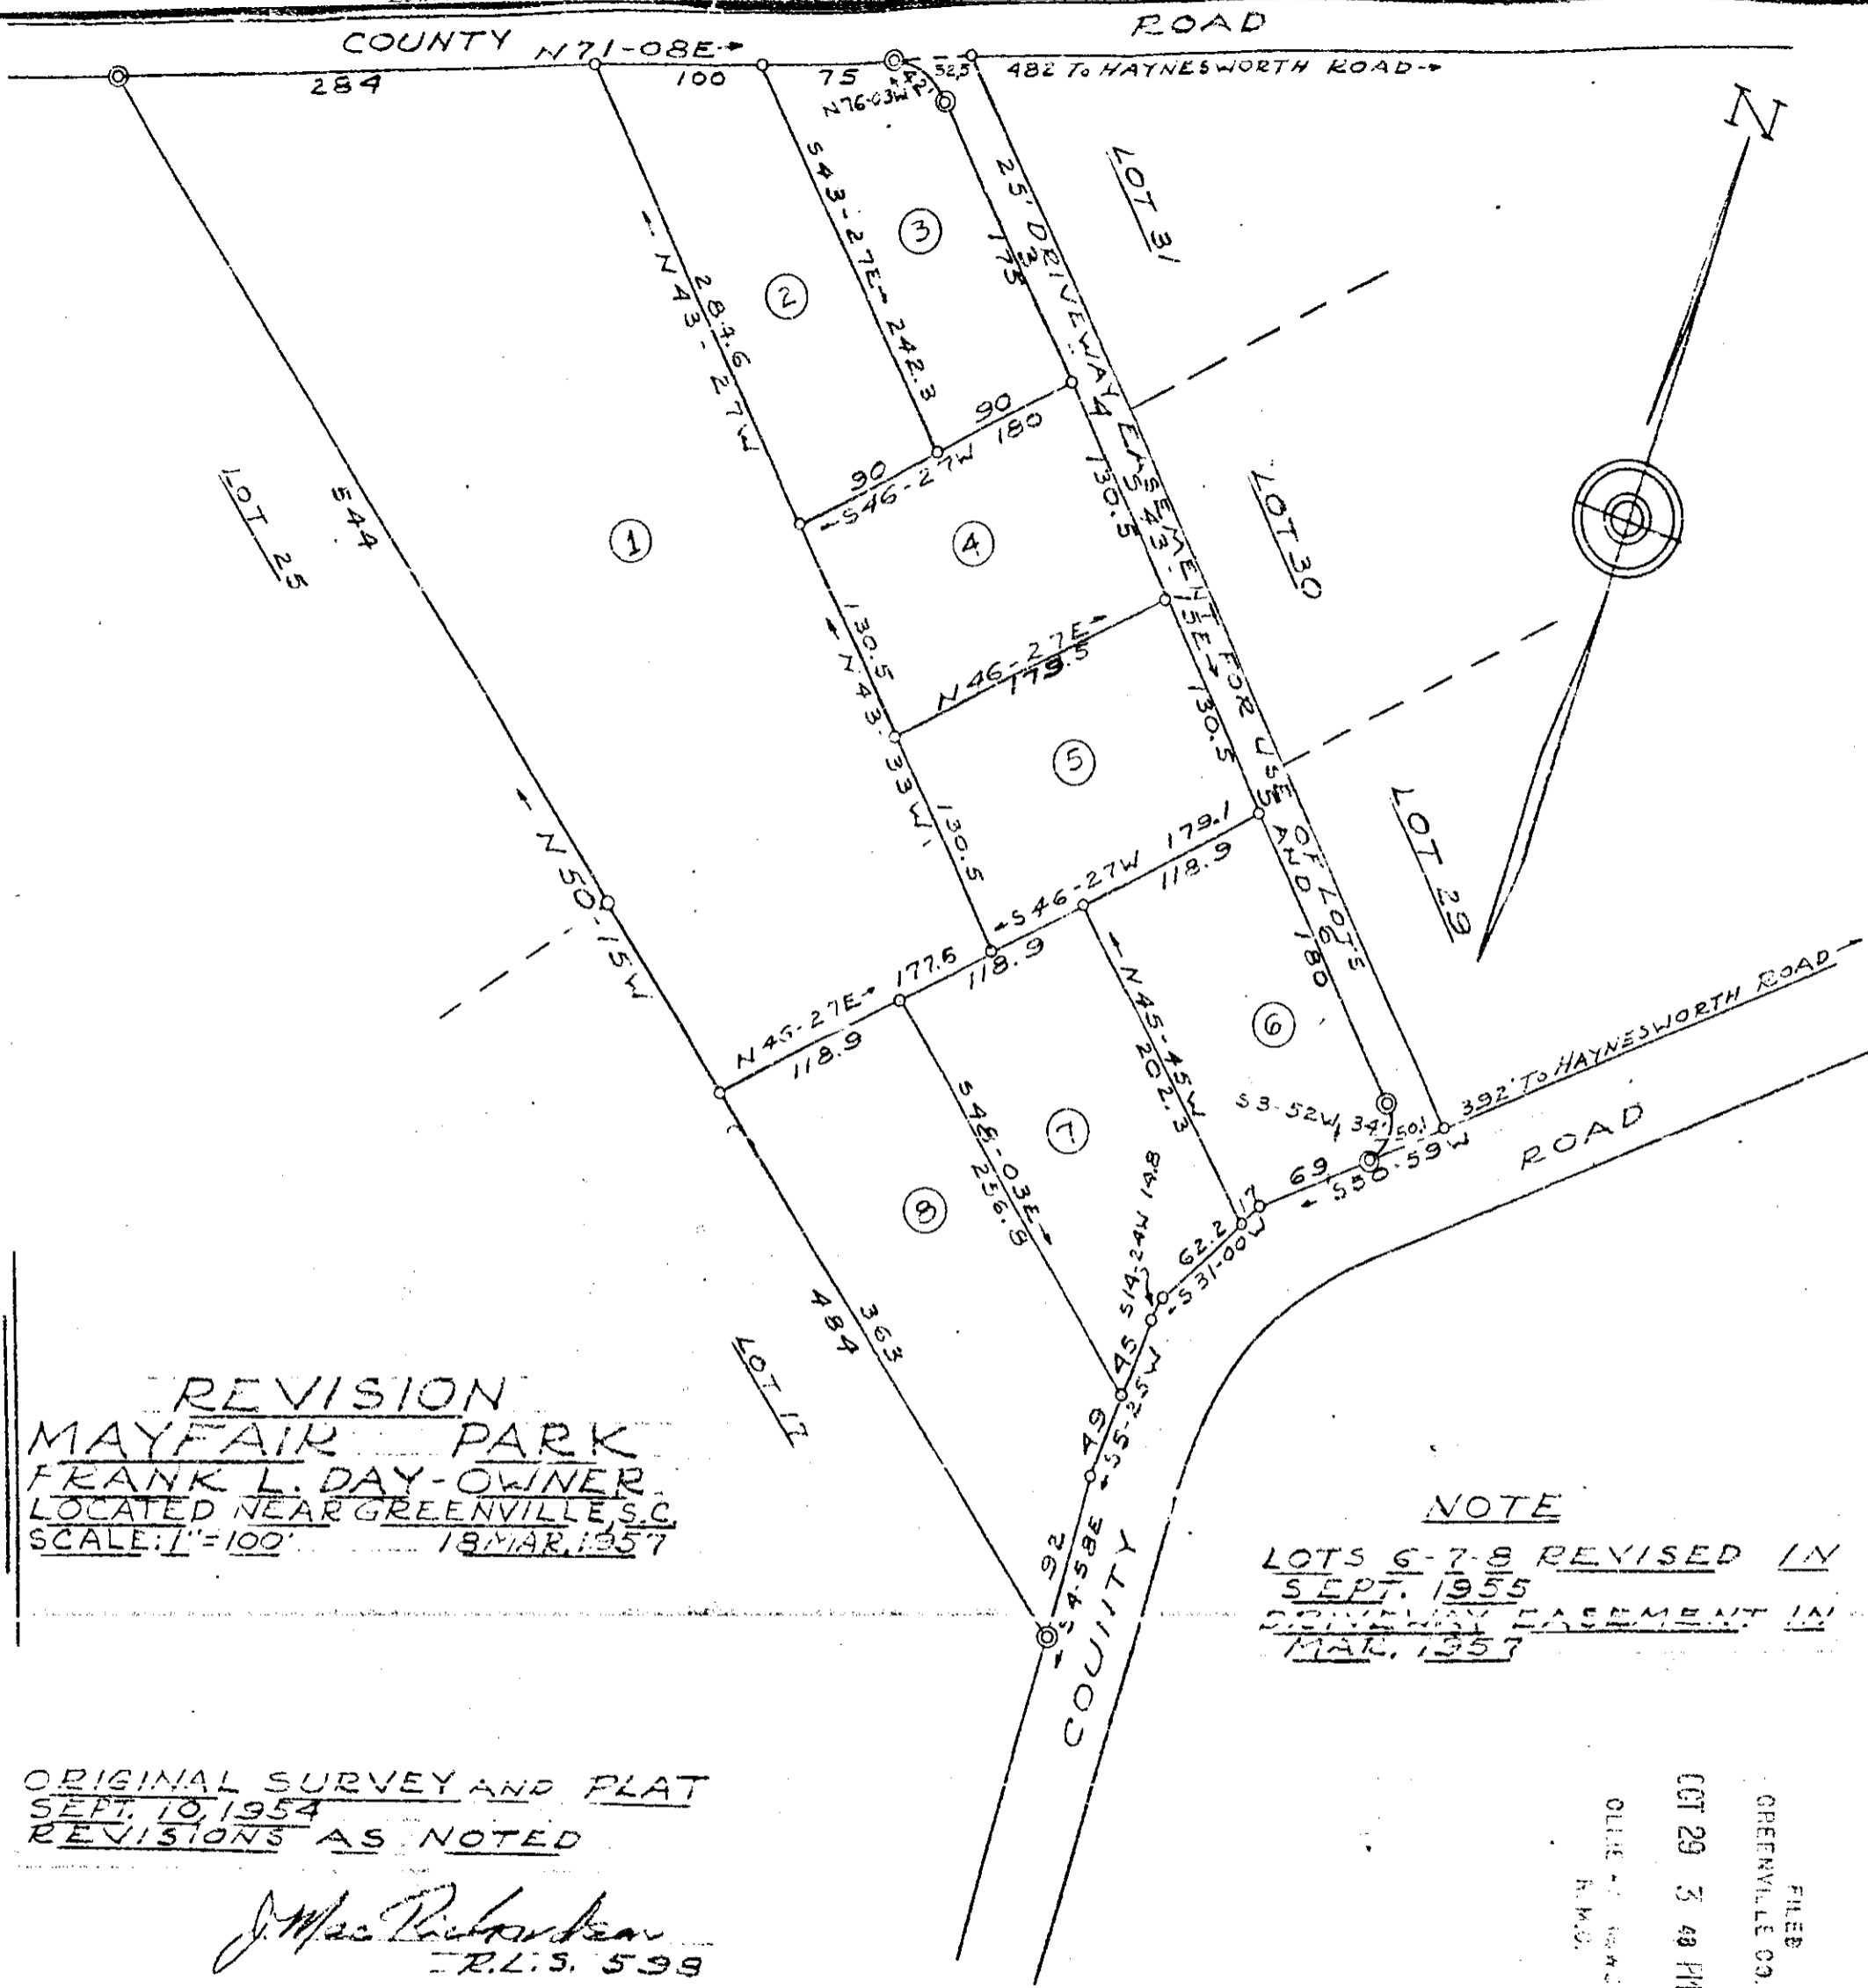

REVISION  
 MAYFAIR PARK  
 FRANK L. DAY - OWNER  
 LOCATED NEAR GREENVILLE, S.C.  
 SCALE: 1" = 100' 18 MAR. 1957

NOTE  
 LOTS 6-7-8 REVISED IN  
 SEPT. 1955  
 DRIVEWAY EASEMENT IN  
 MAR. 1957

ORIGINAL SURVEY AND PLAT  
 SEPT. 10, 1954  
 REVISIONS AS NOTED

*J. Mac Robertson*  
 R.L.S. 599

NOTE: ABOVE PROPERTY COMPRISES  
 LOTS 27 & 28 OF FARR ESTATES

○ DENOTES IRON PIN  
 ⊙ DENOTES CONC. MON.

FILED  
 GREENVILLE CO., S.C.  
 OCT 29 3 40 PM 1959  
 OLIVE H. BOWEN  
 R.M.S.

17994 Filed This 29th day of OCT 1959  
 and Recorded in Vol. 1 Page 67 of T.T.  
 Register Map & Conveyance Greenville County, S.C.

OCT 29 1959 12991 T T - 67

010

3rd 1959