


BRIDGEWATER

DRIVE

FILED
GREENVILLE CO. S. C.

MAY 9 5 02 PM 1960

OLLIE FARNSWORTH
R. M. C.

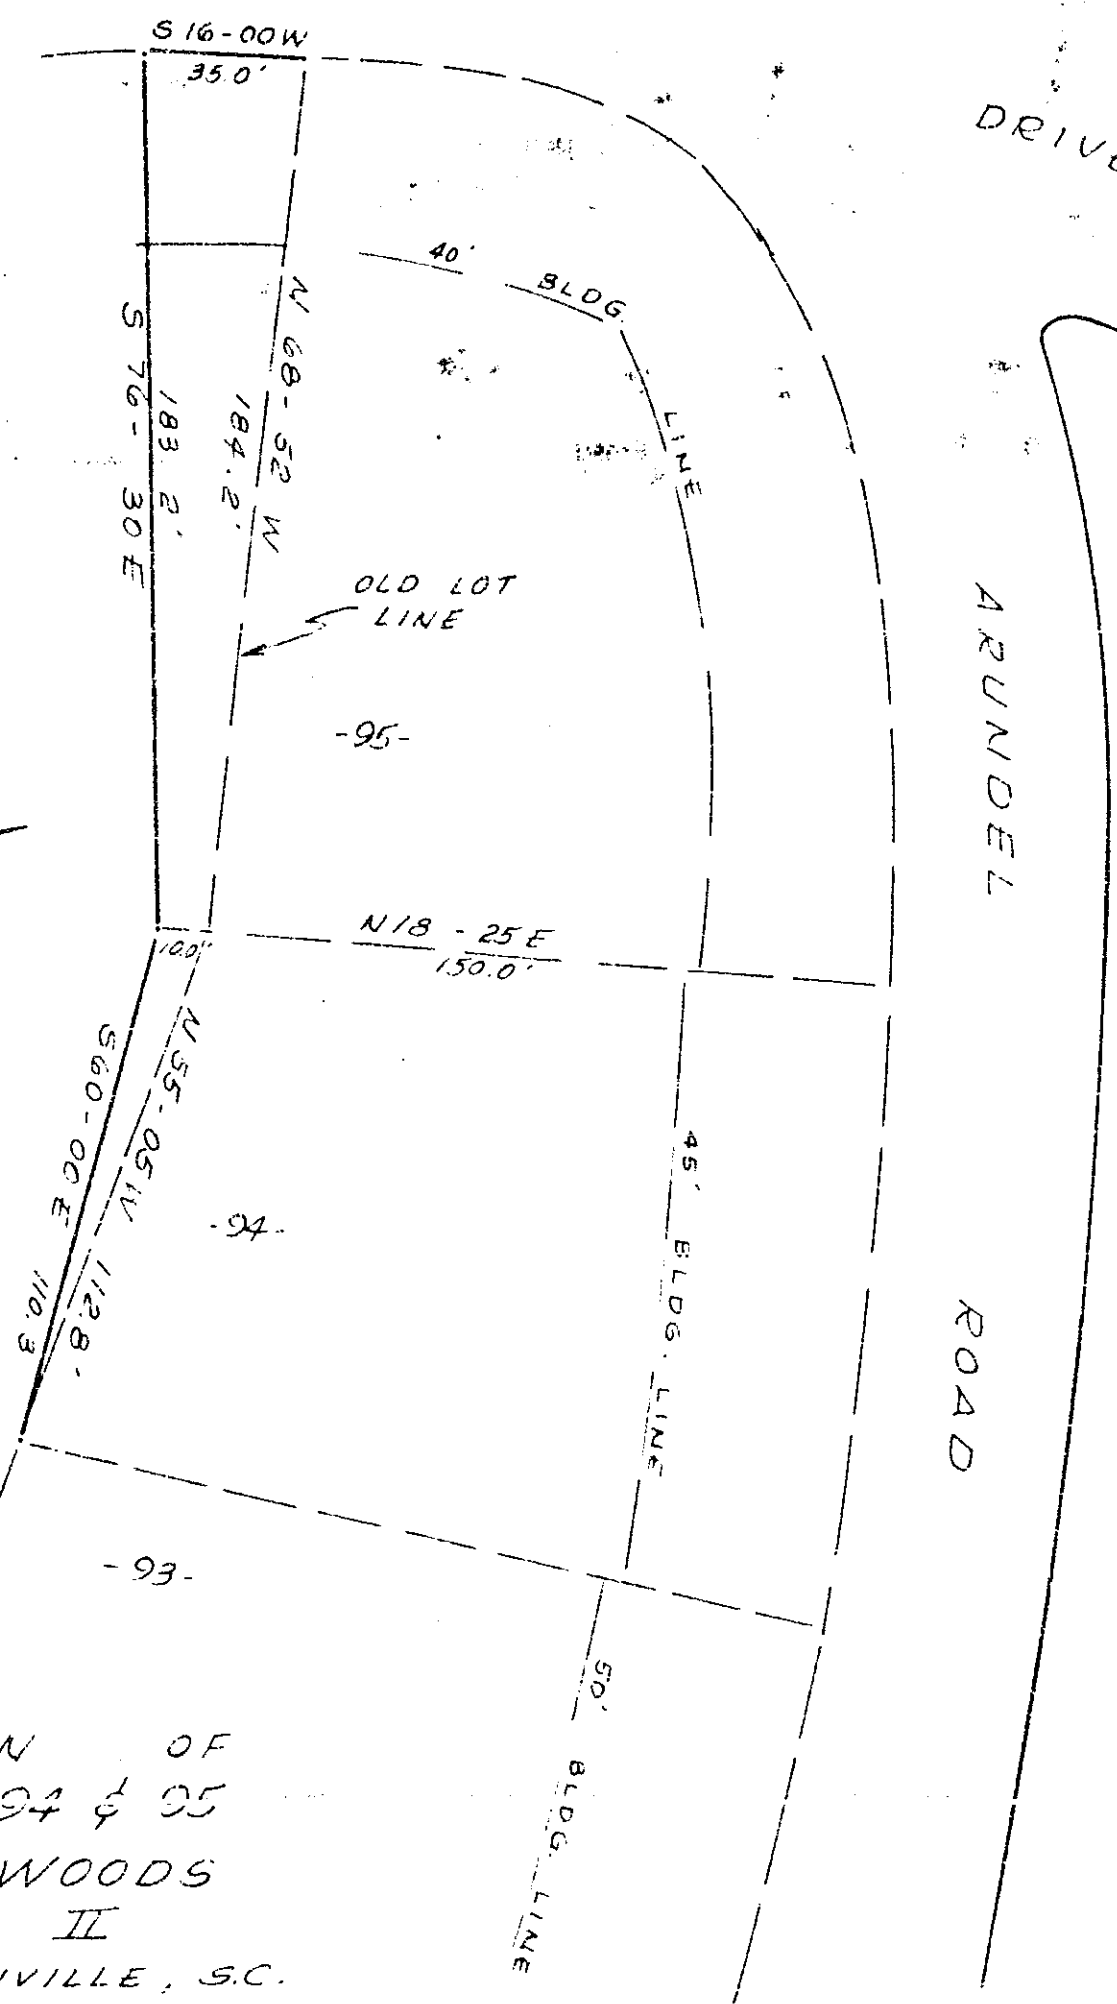

REVISION OF
LOTS 94 & 95
BOTANY WOODS
SECTOR II
NEAR GREENVILLE, S.C.

SCALE 1" = 50' MAY 2, 1960

MAY 9 1960

PIEDMONT ENGINEERING SERVICE
GREENVILLE, S. C.

30664



TT-192

30664 Filed This 9 day of May 1960

And Recorded in Book 192 at 11

Ollie Farnsworth

Register Meigs Constance Greenville County, S. C.