


# Plat Book TT, Page 197 B

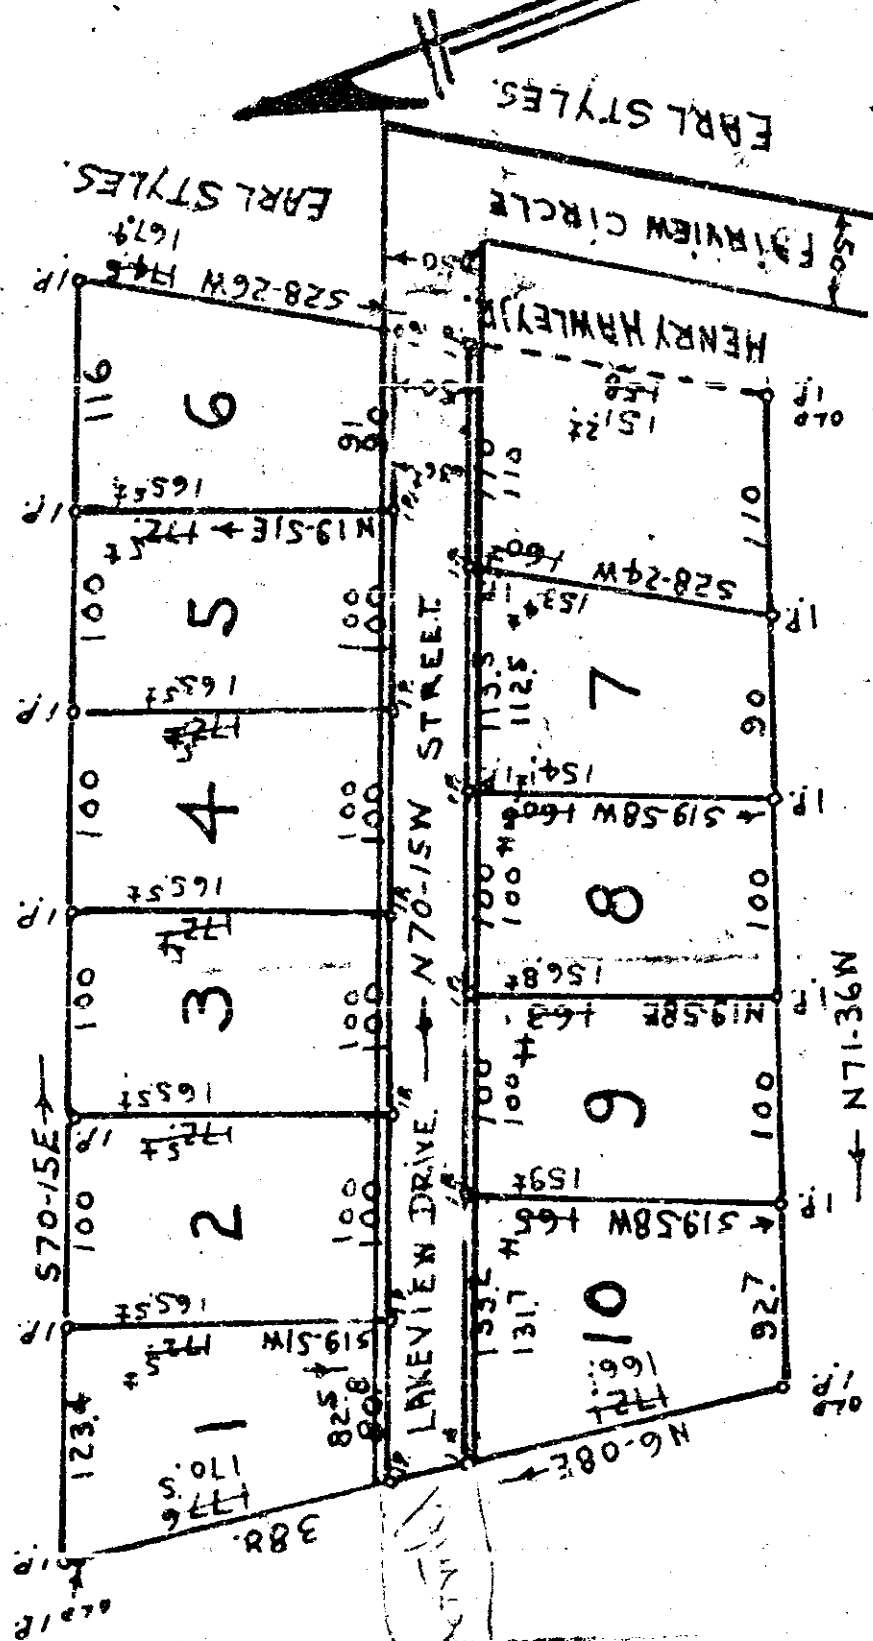

LAND SURVEY FOR  
**W. P. JOHNSON; G'VILLE, CO. S.C.**  
 4-25-1959. 1"=100' REF. PLAT H. S. BROCKMAN. FOR  
 J. B. AND M. N. CRAIN. EST. 5-12-1948.  
 J. Q. BRUCE, REGISTERED SURVEYOR. S.C. NO. 667.  
 PLAT REVISED 10-7-1959. TO CHANGE 36<sup>TH</sup> STREET TO  
 BE 50' STREET. J. Q. BRUCE REG. SUR.  
 STREET TO BE 50 FT. SUBJECT TO CONFORMATION  
 BY ADJACENT OWNERS.

W.P. Johnson  
 MAY 14 1960  
 31330  
 TT-197

31330 Filed This 14 day of May 1960  
 and Recorded in Vol. TT Page 197 of 1 #  
 Eddie Fawcett  
 Register Measur Conformance Greenville County, S.C.