

This is to certify that on Dec. 27, 1960, I surveyed Lot No. 80 Section 1 of Lake Forest, filed in E. C. Office for Greenville Co. in Plat Book "GG" at page 17, and that the property lines, walls and building are as shown hereon; that the building located on said lot does not encroach or project on adjacent streets or property, and that no adjacent walls or buildings encroach or project on said premises, and that no utility lines cross this property except as shown hereon.

Surveyed by R. K. Campbell

C. Res. No. 936

OLIVER R. NORTH
F.M.O.

JAN 6 11 53 AM 1961


GREENVILLE CO. S. C.

JAN 6 1961

PROPERTY OF
MATTHEW & ALIDA W. HANSCOM
NEAR GREENVILLE S.C.
SCALE 1" = 30' DEC. 27, 1960

16954

P.B. "UU" - 170 *MC*

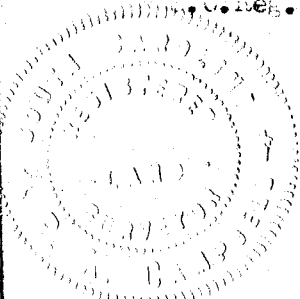

16954 Filed This 6 day of Jan. 1961
And Recorded in Vol. 4 Page 170

Alida W. Hanscom
Register Mesne Conveyance Greenville County, S. C.