
EMMALA B& ELIZABETH C. JONES FILED IN PL.BK. "E" PAGE 37.

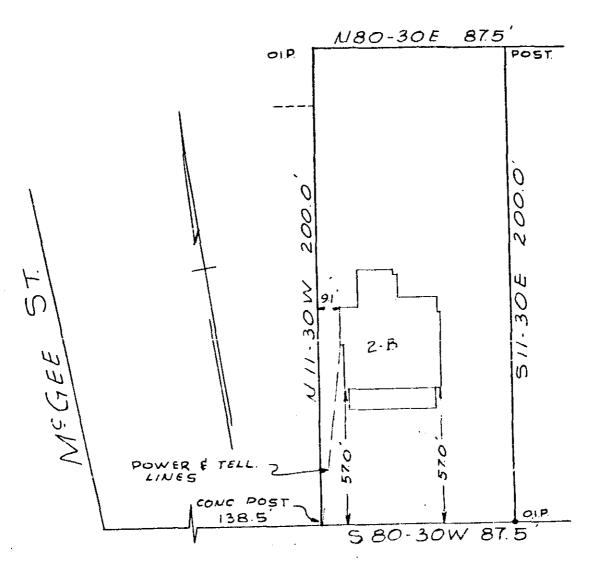

EAST AVENUE

PROPERTY

BELLE TAYLOR LAWRENCE R. TAYLOR & LONA

GREENVILLE, S.C Scale I"= 50' 20

20 JAN 1961

This is to certify that on the 20th day of January 1961, I surveyed the property shown on this plat, and that the property lines, walls and buildings are as shown hereon; that the buildings located on said lot do not encroach or project on adjacent streets or property, and that no adjacent walls or buildings encroach or project on this lot; and that there are no utility lines crossing this property except as shown.

J. IAN 251961 18581

Registered Engineer No. 962

VV -17

1858 4 Fred This & Saw of Jam 10 61 and Recorded in Vill V Prive 17 In M. Register Mesne Conveyance Greenville County, S. C.