
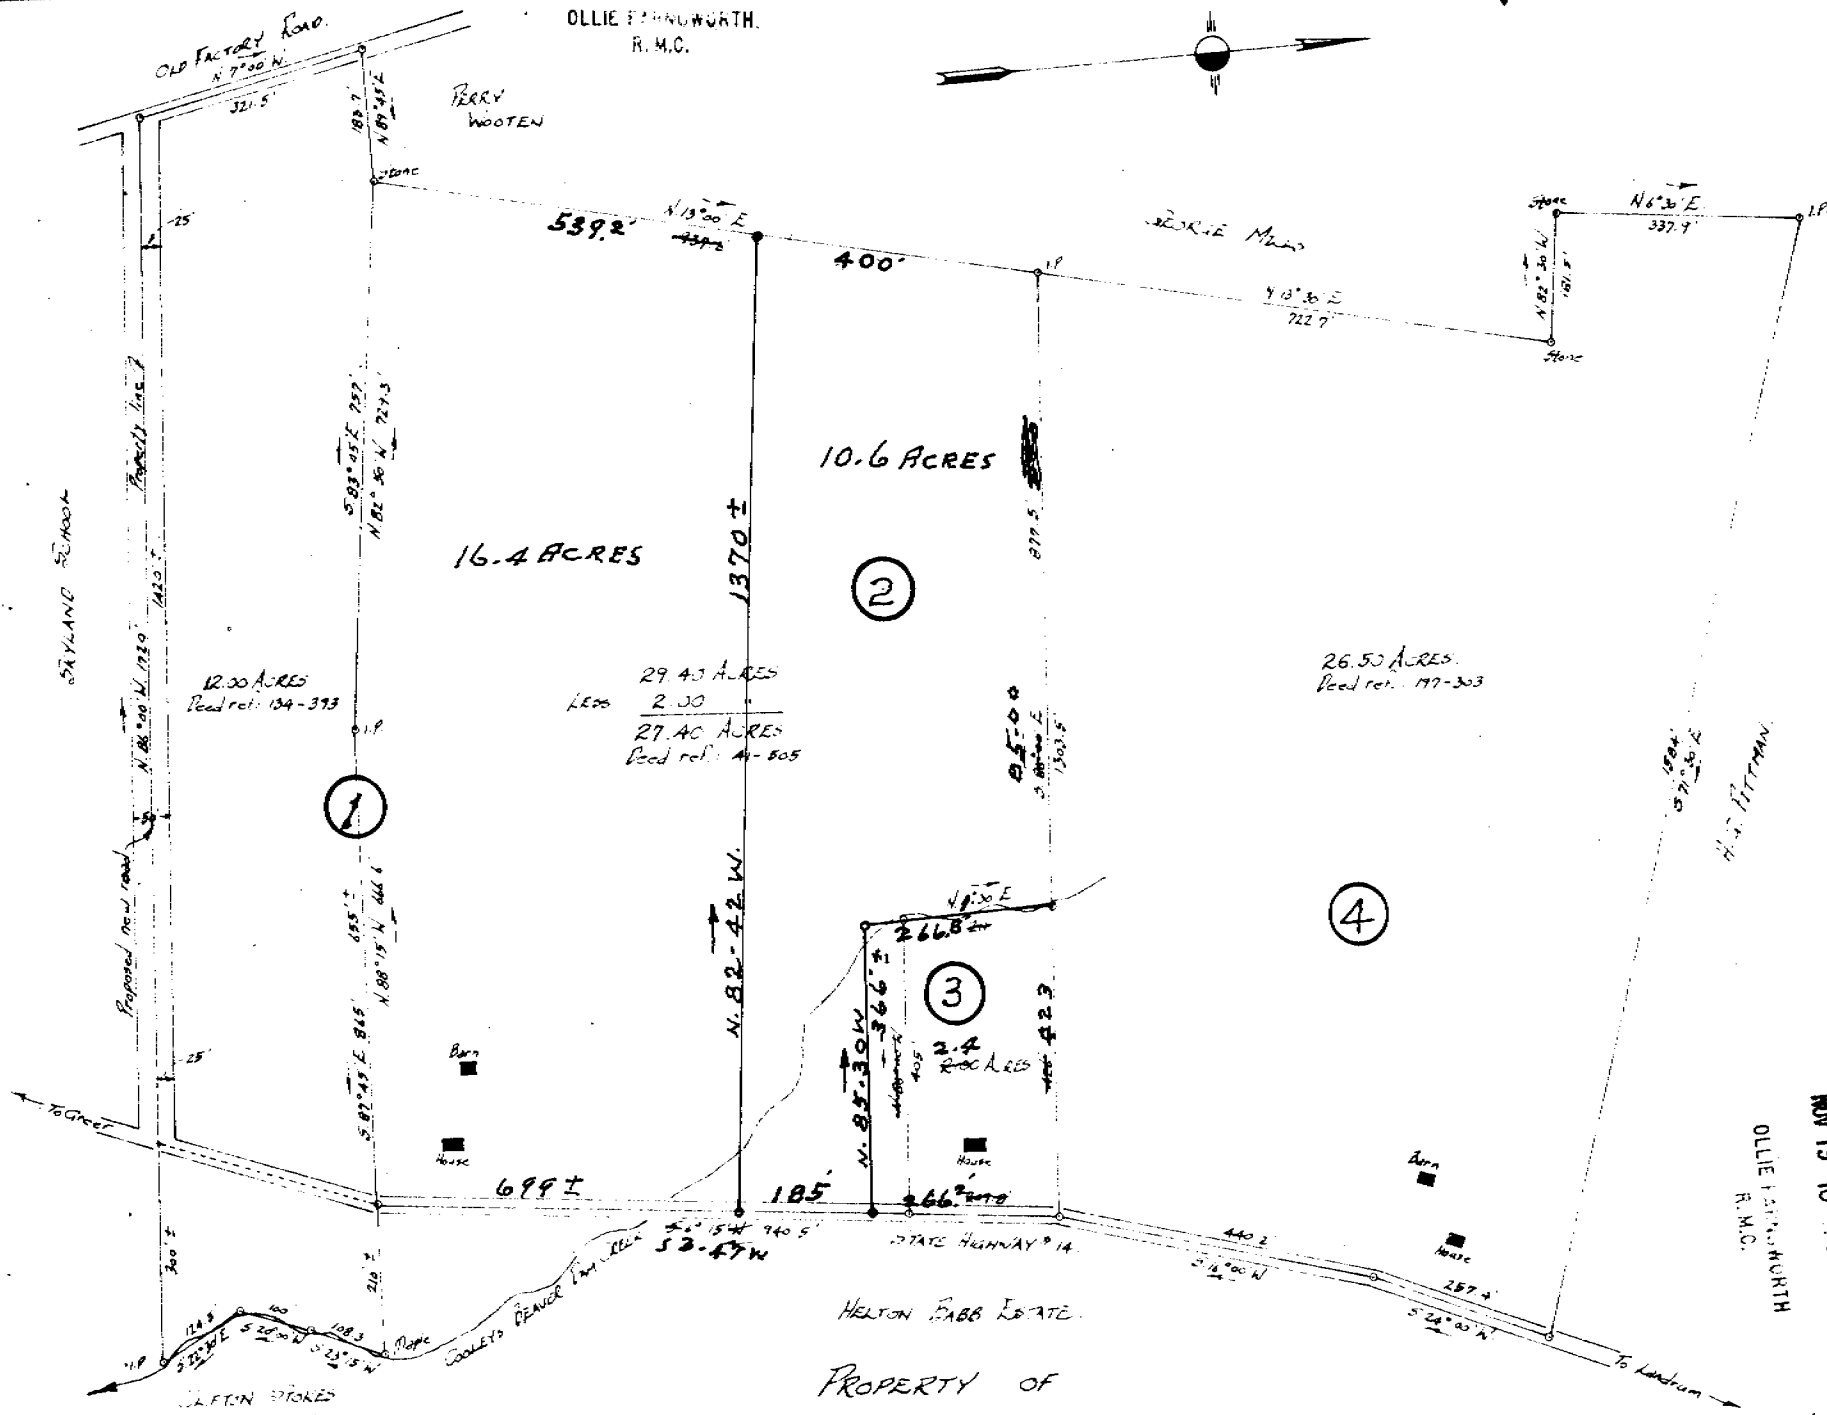


OLLIE FARNSWORTH.  
R. M. C.

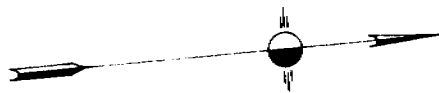

12.00 ACRES  

LESS 2.00
27.40 ACRES

26.50 ACRES.  

PROPERTY OF  
**ALLEN C. FEW.**  
located near Skyland school  
HIGHLAND TOWNSHIP GREENVILLE COUNTY  
SOUTH CAROLINA.

Rerecorded November 19, 1962 at 10:43 A. M. #13176

NOV 19 10 43 AM 1962

FILED  
GREENVILLE CO. S. C.

OLLIE FARNSWORTH.  
R. M. C.

13176

NOV 19 1962

H. S. BROCKMAN, Reg. Surveyor #789

20591

APR 28 1960

SCALE: 1" = 200 FEET.

APRIL 18 1960.

NOTE: The drive post marks from instrument on this survey should be as noted.