


Plat Book WW, Page 423

FILED
GREENVILLE CO. S. C.

JAN 8 8:37 AM 1963

OLLIE F. LEE, NORTH
R.M.C.

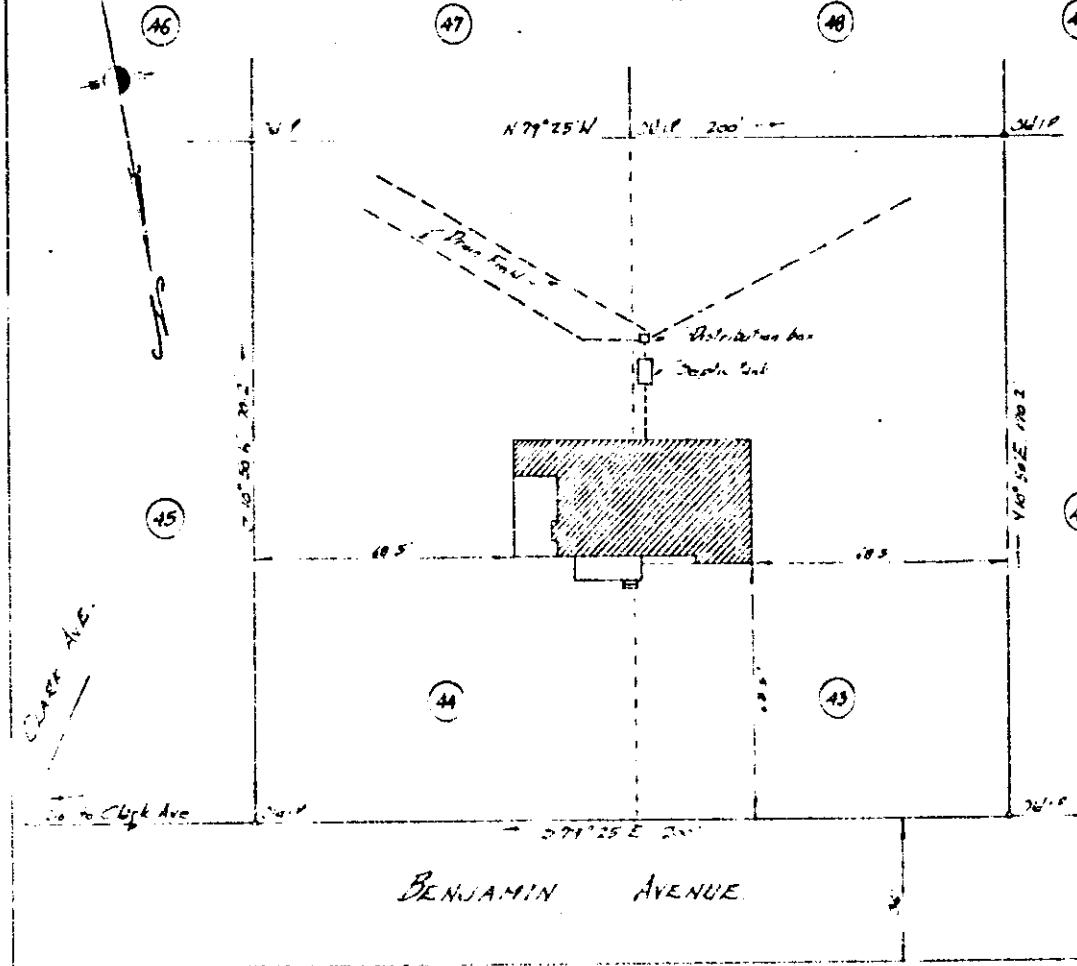

JAN 8 1963

31155
Recorded January 8, 1963 at 8:37 A. M. #17255

Plat Book WW - 423