Plat Book W.W. Page 498

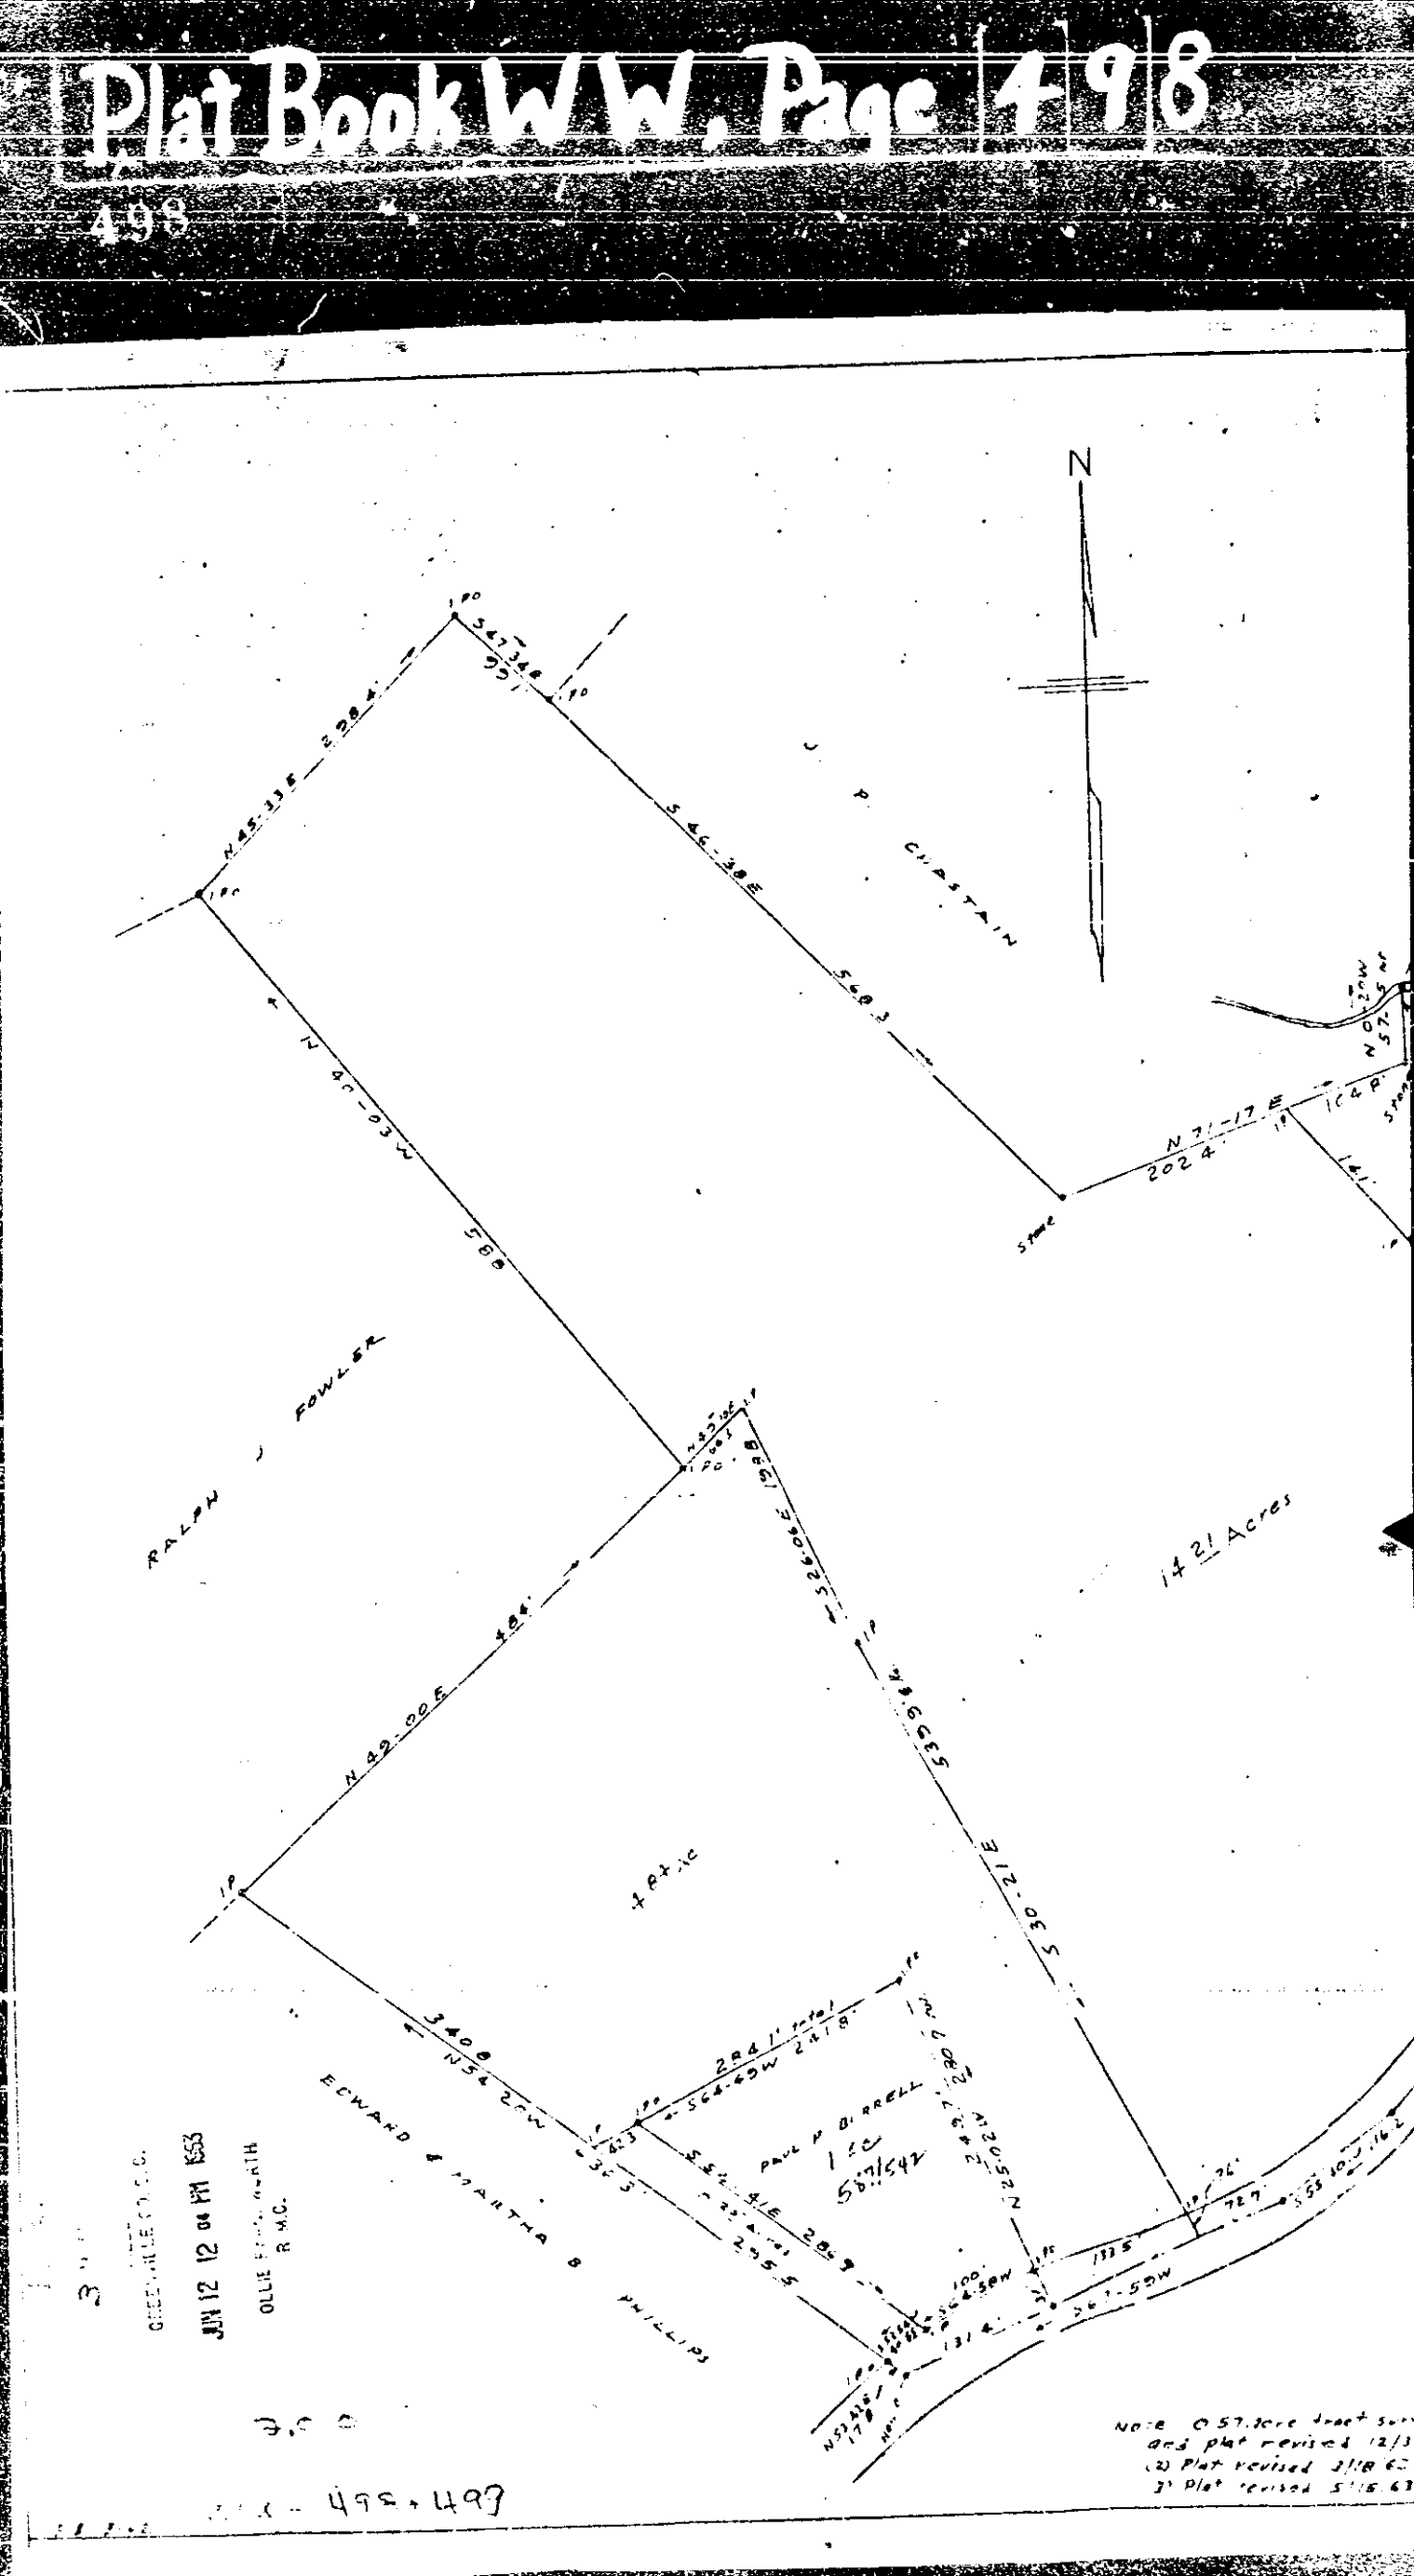

Note ... 57.3 acre tract ...
and plat revised 12/3...
(2) Plat revised 3/18 6...
3) Plat revised 5/16 6...

495-497