


75

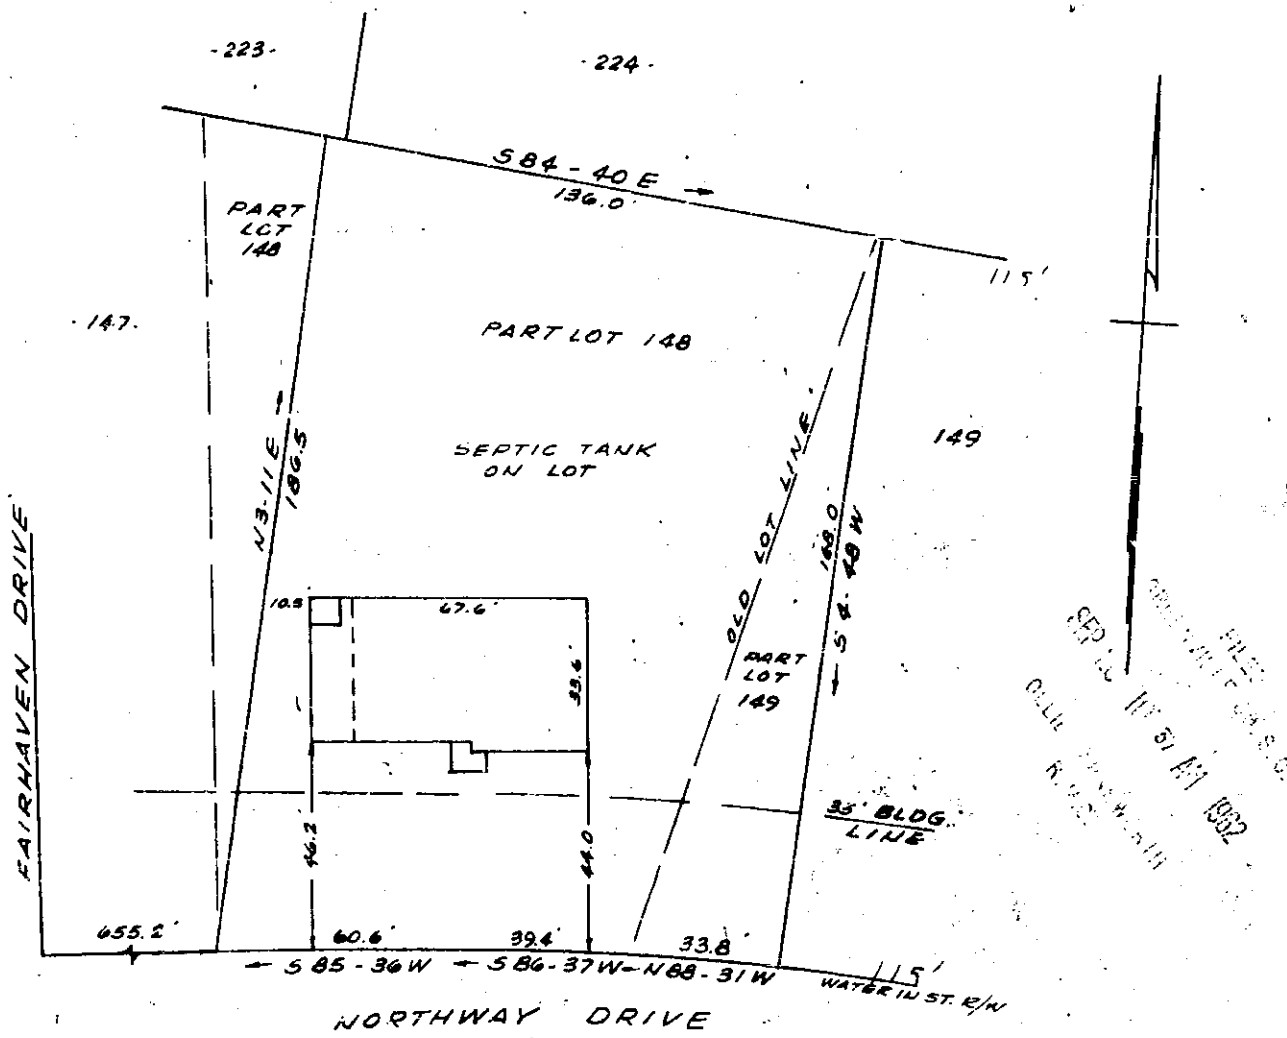

PROPERTY OF
ARTHUR MILLER JR.
 NEAR GREENVILLE, S.C.
 SCALE 1" = 40' SEPT. 1962

This is to certify that on the 26th day of September 1962, I surveyed the property shown on this plat, being known as a part of lots 148 & 149, on plat of Section II ORCHARD ACRES and recorded in the R.M.C. Office Greenville County, S.C. in plat book "QQ" page 6; and also being known as property of Arthur Miller Jr. recorded in the R.M.C. Office in plat book page ; and that the property lines, walls and buildings are as shown hereon, and that the buildings located on said lot do not encroach or project on adjacent street or property, and that no adjacent buildings or walls encroach or project on said premises.

R. B. Bruce
 R.B. Bruce R.L.S. # 1952.

SEP 28 1962

XL-75

.50

8524 Filed This 28 day of Sep 19 62
 and Recorded in vol. XX Page 75 of
 [Signature]
 Register in office at Greenville County, S.C.

1 BAD COPY