


Plat Book-XX-Page 123

23379 Filed 7-2-1963
 And Recorded 7-2-1963

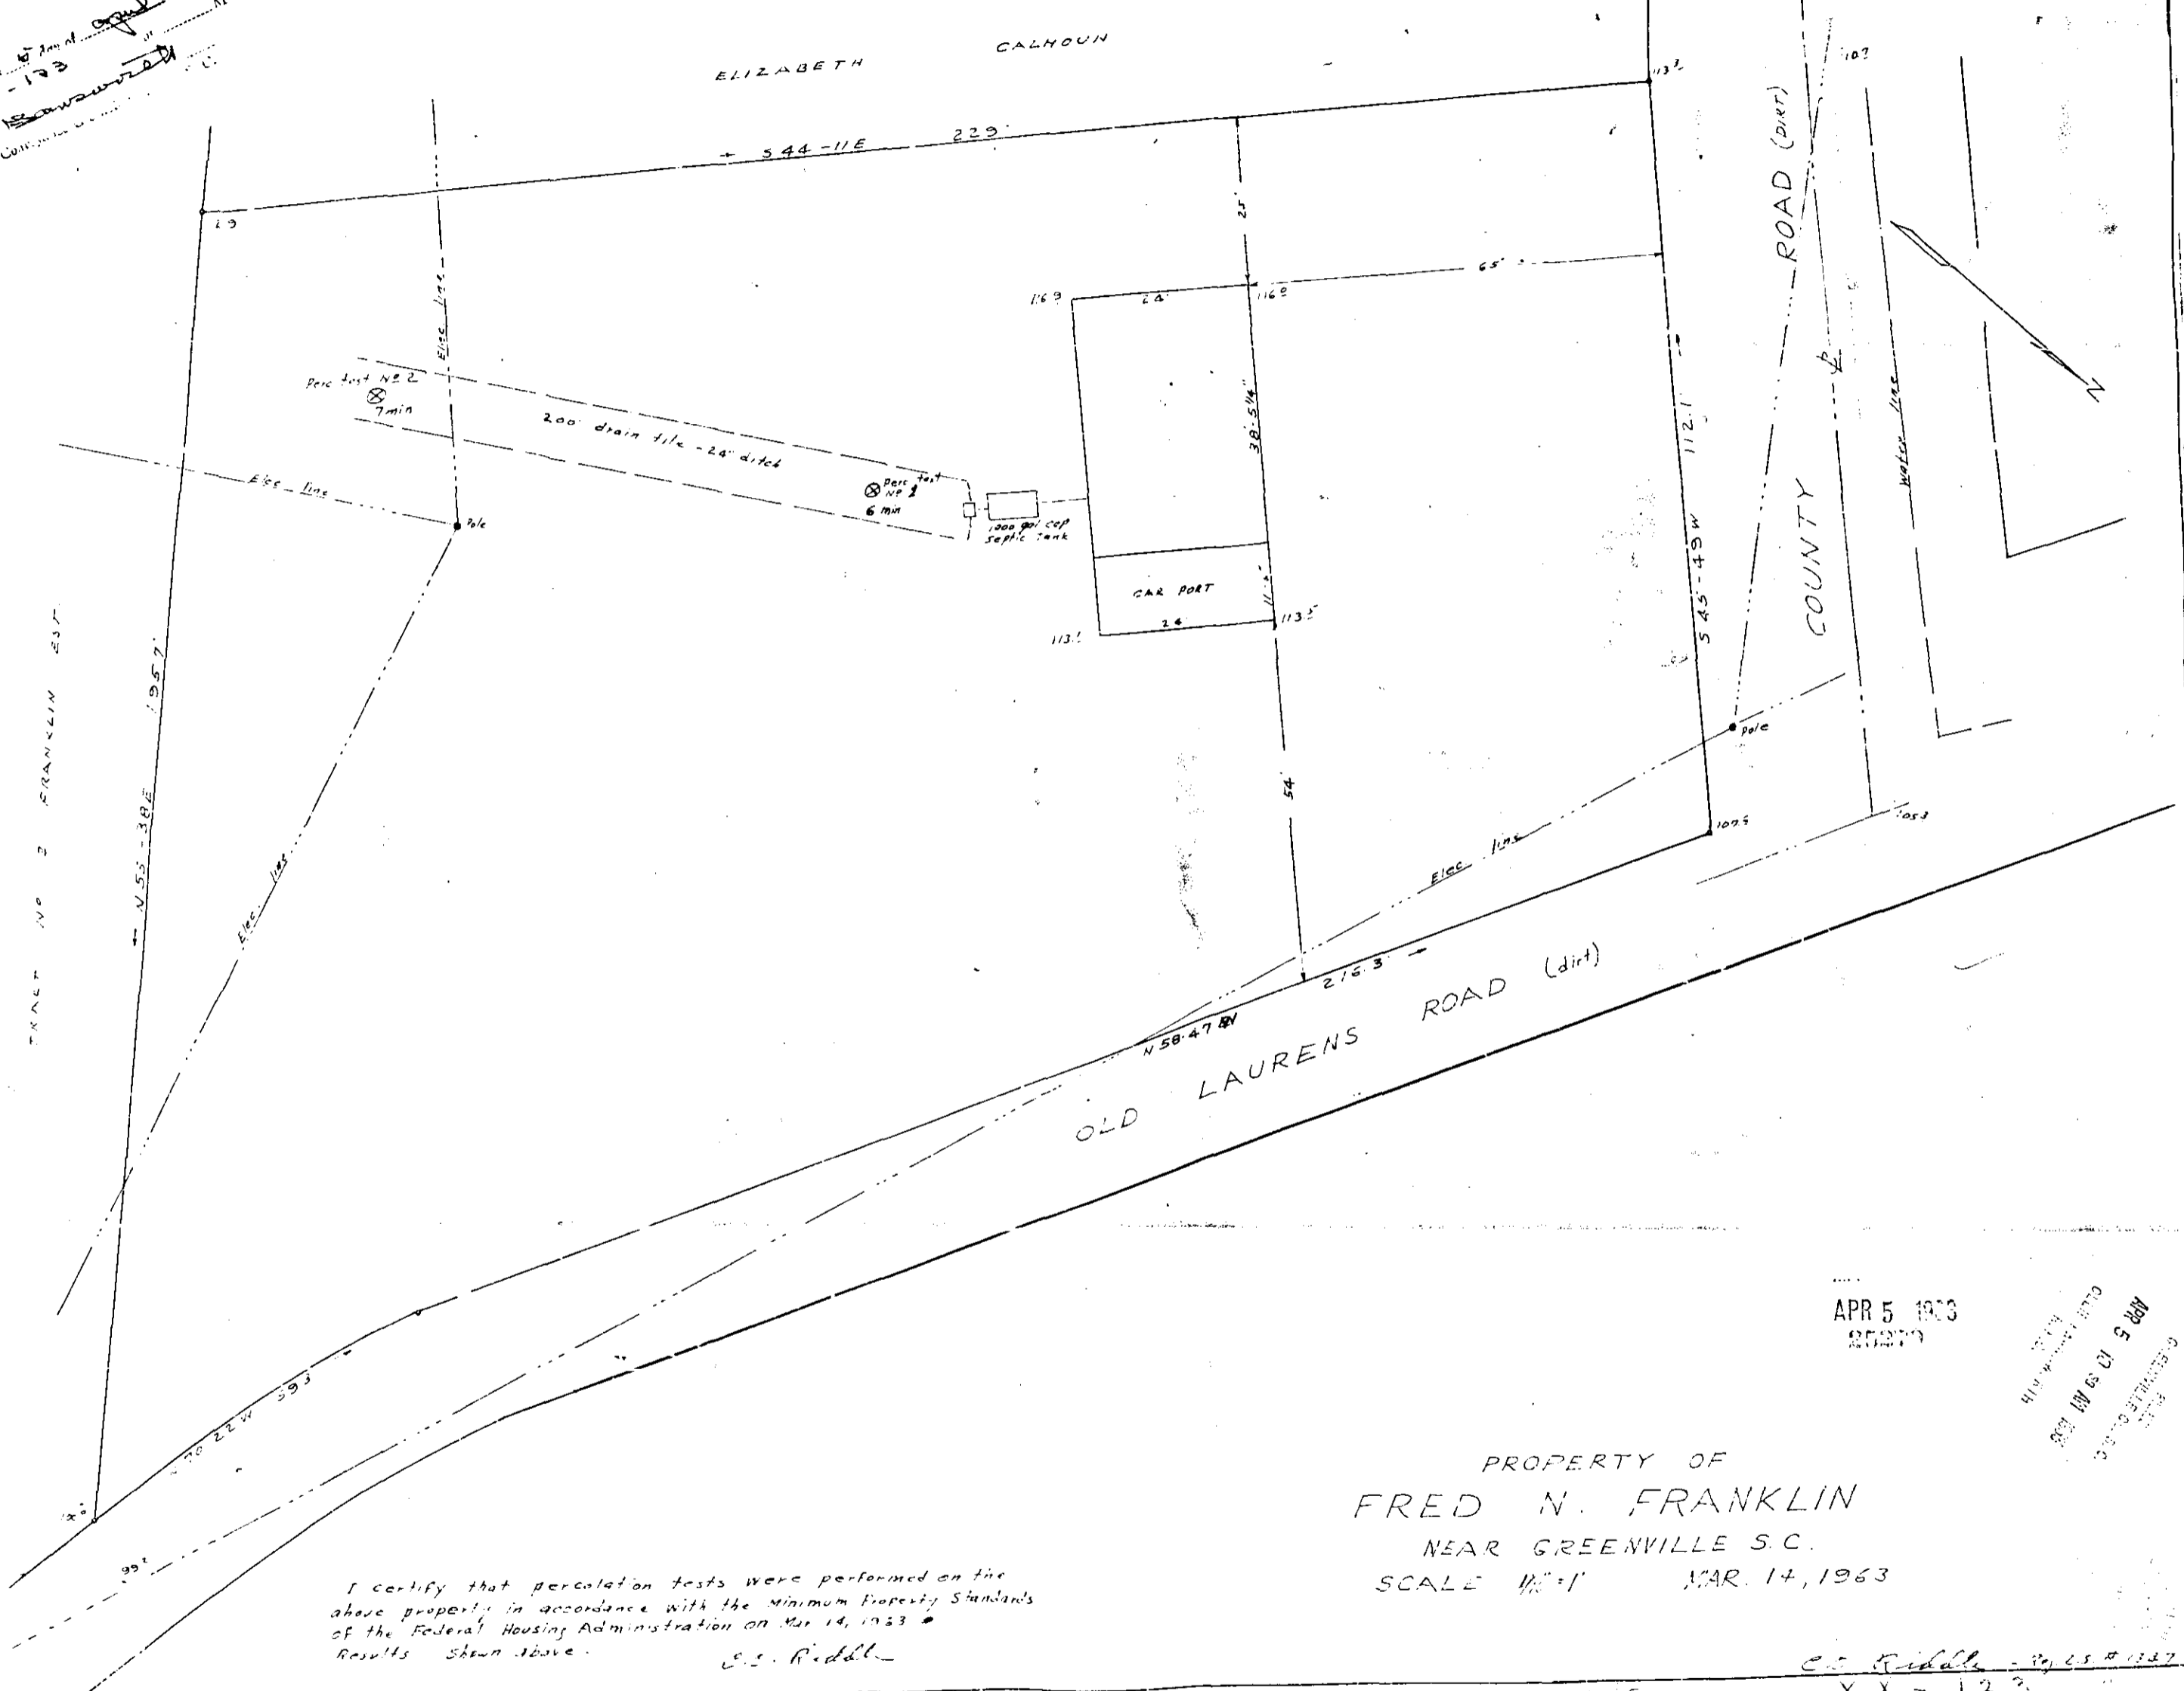

I certify that percolation tests were performed on the above property in accordance with the Minimum Property Standards of the Federal Housing Administration on Mar 14, 1963. Results shown above.
 E.S. Riddell

PROPERTY OF
 FRED N. FRANKLIN
 NEAR GREENVILLE S.C.
 SCALE 1/4" = 1' MAR. 14, 1963

APR 5 1963
 20279

REC'D
 APR 5 1963
 20279

 XX-123

