


OFFICIAL FILED
 20 S.C.
 MAY 13 3 10 PM '80
 RONALD E. NORRIS
 JAMES R. FREELAND

This is to certify that on May 13, 1980, I surveyed the premises shown on this plat, known as property of Jan Richard Fox and Jane M. Fox, recorded in the office of Greenville County, in Book 44, Page 23, and that the property lines, walls and easements are as shown hereon; that the buildings located on said lot do not encroach or project on adjacent streets or property, and that no adjacent walls or buildings encroach or project on said premises, and that no utility lines cross this property except as shown hereon. This property is not located in a designated flood hazard area.

MAY 13 1980

7-7-86 33114

James R. Freeland
 200 S. ... Greenville, SC 29601

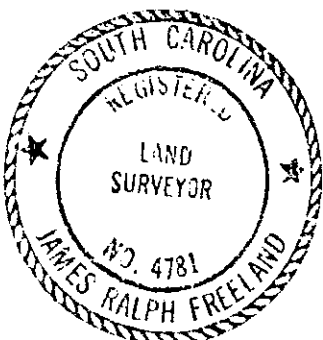

SEAL

STATE OF SOUTH CAROLINA
 GREENVILLE COUNTY

PROPERTY OF
 RONALD E. NORRIS
 JACK M. HOWARD JR.

FREELAND & ASSOCIATES
 Greenville, SC

SURVEY R.K.P.
 DRAWN M.C.
 CHECK M.C.
 SCALE 1" = 40'
 DATE 5-9-80
 DWG NO 80-5038

