


777.27

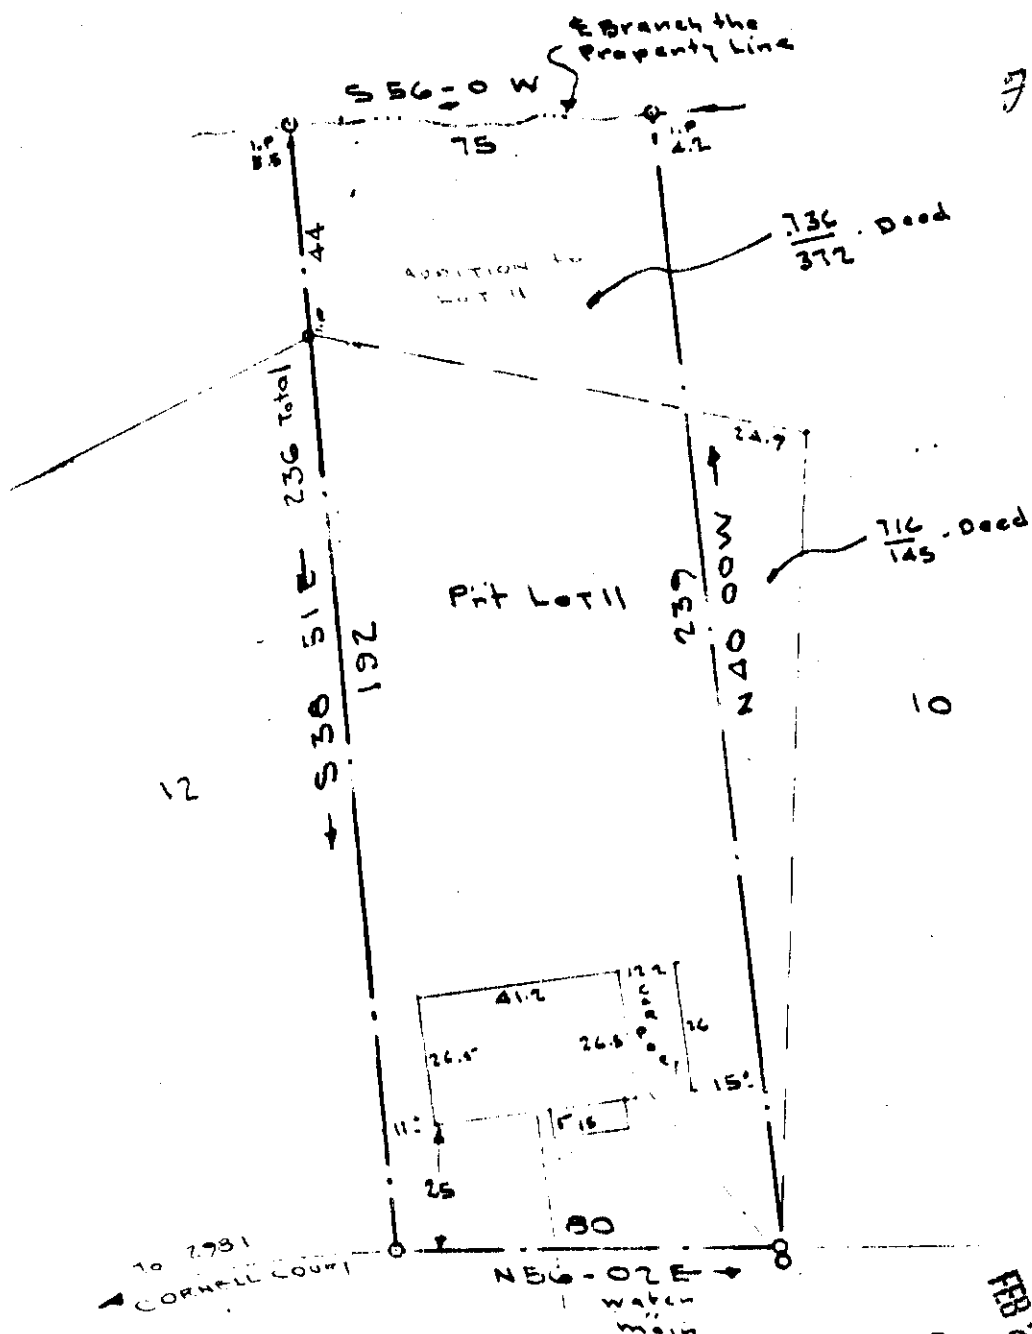

to 2781  
CORNELL COURT

CURTIS RD

FEB 24 1964

23932

FILED  
GREENVILLE CO. S.C.  
FEB 24 12 22 PM 1964  
OLLIE FAHNSWORTH  
R.M.E.

This is to certify that on the 24<sup>th</sup> day of FEB 1964, I surveyed the property shown on this plat, being of TERRY D. GUNTHER & VIRGINIA H. GUNTHER - Part of Lot II - Farley Jones Reg. recorded in Plat Book N. 4 FFF. 89-27 of the S.C. Office for Greenville County, S.C. and that the property lines, walls and buildings as shown hereon; that the buildings located on said lot do not encroach or project on adjacent streets or property; and that no adjacent buildings or walls encroach or project on said premises, and that no utility lines cross this property.

PROPERTY OF  
TERRY D. GUNTHER  
& VIRGINIA H. GUNTHER  
GREENVILLE COUNTY, S.C.  
SCALE 1"=40' FEB-7-1964

50

Reg. Engineer No. 1144 S.C.

C. E. JONES - Civil Engineer

23932 Filed This 24 day of Feb. 19 64  
And Recorded in Vol. FFF Page 27 at M  
  
Register Mesne Conveyance Greenville County, S. C.