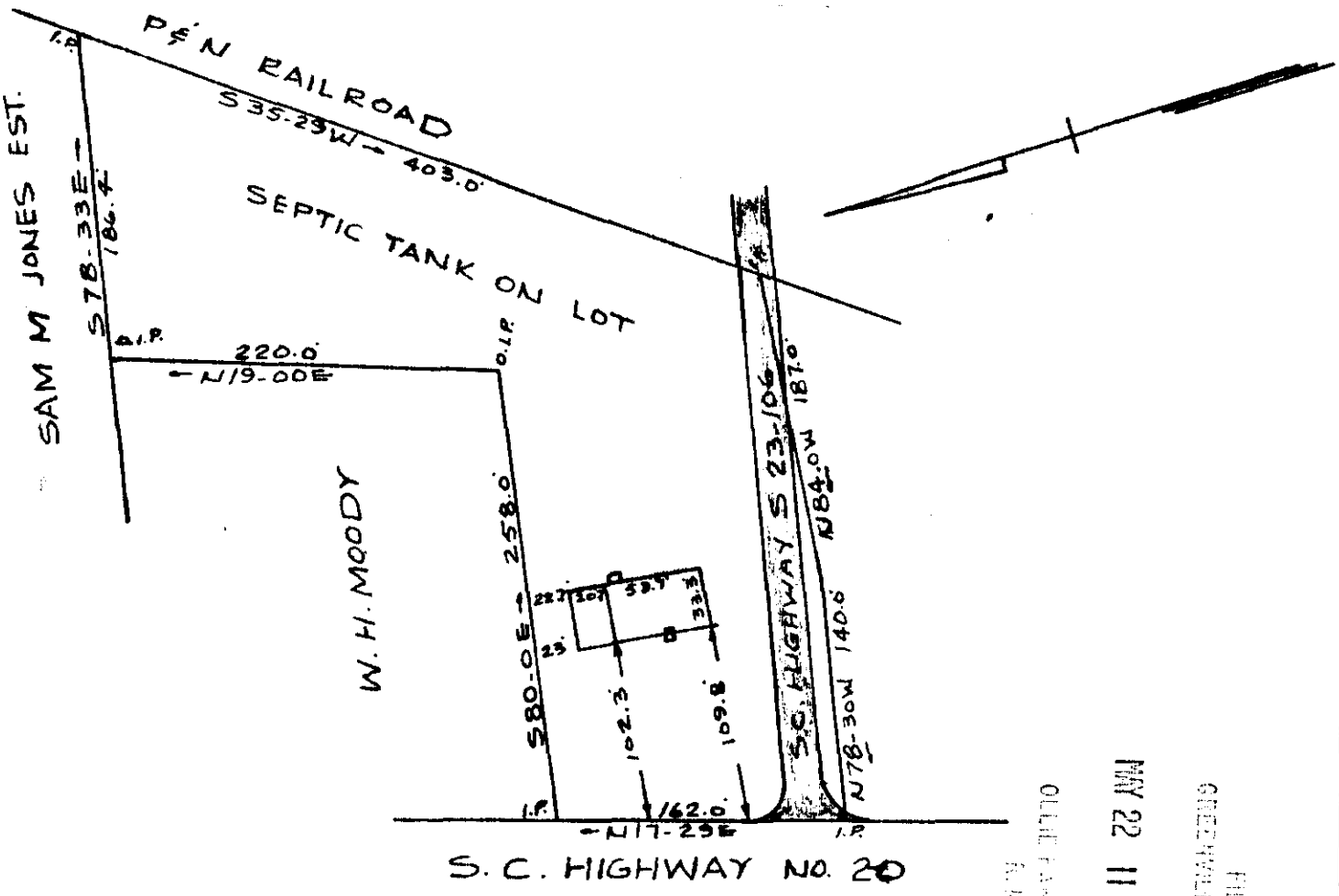

PROPERTY OF
THOMAS CLAUDE THORNTON
NEAR GREENVILLE, S.C.
SCALE 1" = 100' 7 MAY 1964

FILED
GREENVILLE CO. S.C.
MAY 22 11 46 AM 1964
OLLIE FARNSWORTH
R.M.C.

This is to certify that on the 7th day of May 1964, I surveyed the property shown on this plat, being known as property of Thomas Claude Thornton, recorded in R.M.C. Office Greenville County, S.C. in Deed Book 727 page 394, and also being recorded in plat book page ; and that the property lines, walls and buildings are as shown hereon, and that the buildings located on said lot do not encroach or project on adjacent street or property, and that no adjacent buildings or walls encroach or project on said premises.

R. B. Bruce
R.B. Bruce, R.L.S. #1952

MAY 21 1964
33103

FFF-125

50

33103 Filed This 21 day of May 19 64
And Recorded in Vol. FFF Page 125 at M
Register Mesne Conveyance Greenville County, S. C.