NO 156

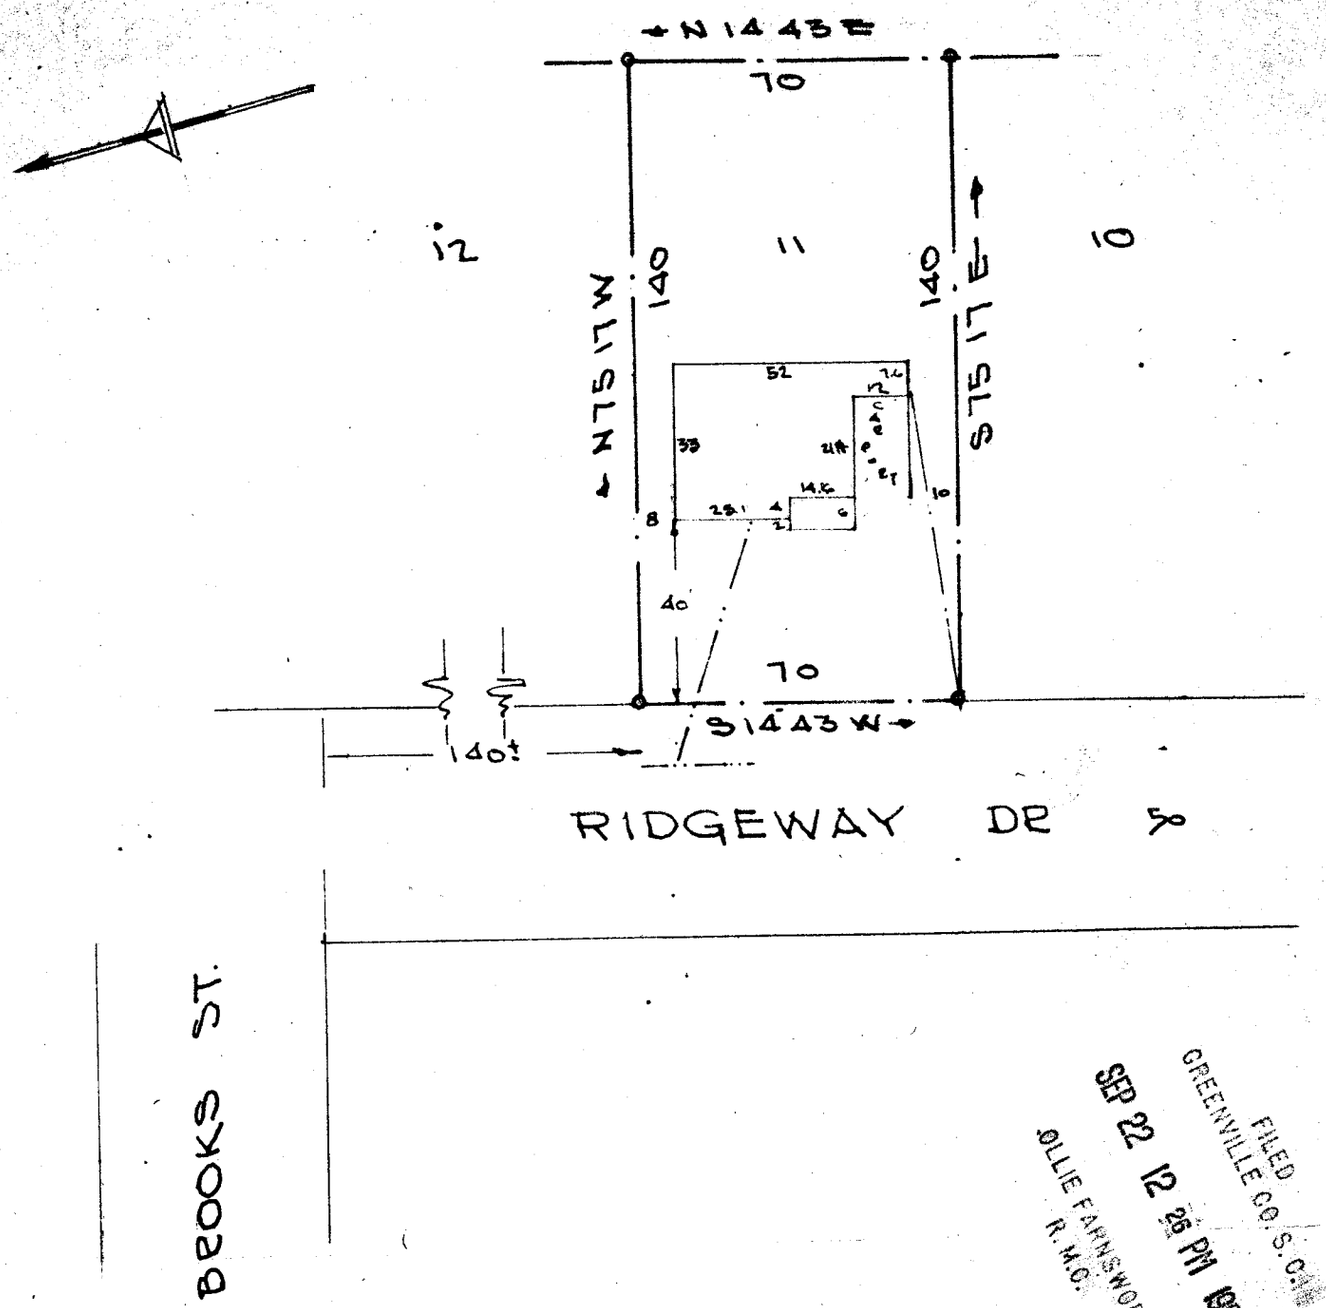

FILED
GREENVILLE CO. S.C.
SEP 22 12 26 PM 1964
OLLIE FARNSWORTH
R.M.C.

PROPERTY OF

DAVID A. MIDDLETON

GREENVILLE COUNTY, S.C.

Scale 1"=40' JUNE 7 1964

This is to certify that on the 7th day of JUNE 1964, I surveyed the property shown on this plat, being LOT 11-Walter Griffin Prop-Not recorded-Also Prop DAVID A. MIDDLETON recorded in Plat Book FFF Pg 159 of the R.M.C. Office for Greenville County, S. C., and that the property lines, walls and buildings are as shown hereon; that the buildings located on said lot do not encroach or project on adjacent streets or property; and that no adjacent buildings or walls encroach or project on said premises, and that no utility lines cross this property.

FFF Page 159

SEP 22 1964

.50 ¢

8848

Reg. Engineer No. 1144

C. C. JONES — CIVIL ENGINEER

8848 Filed This 22 day of Sept. 1964

And Recorded in Vol. FFF Page 159 at 12:26 P M

Ollie Farnsworth

Register Mesne Conveyance Greenville County, S. C.