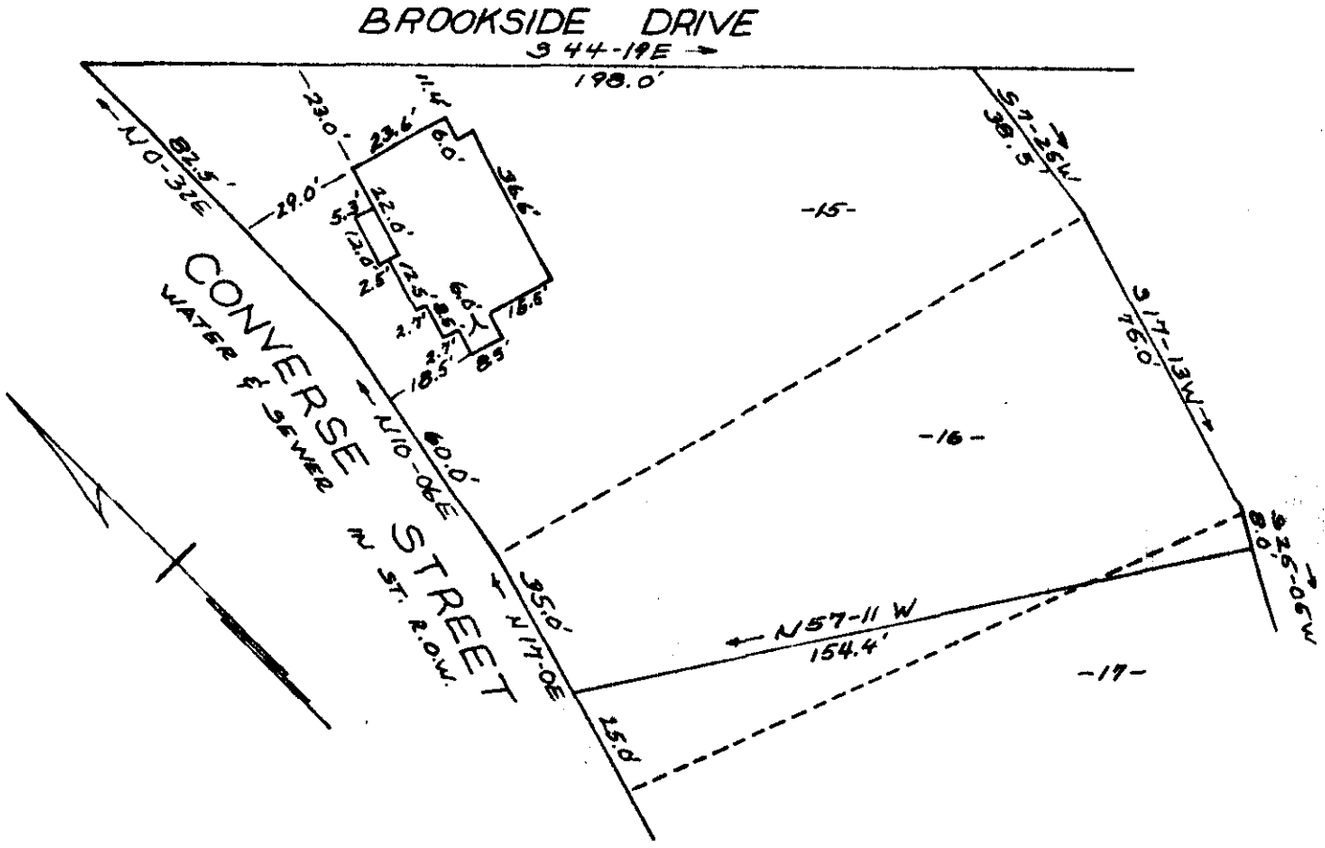

PROPERTY OF
MARIE P. BRADLEY
GREENVILLE, S.C.
SCALE 1"=40' 8 JUNE 1964

This is to certify that on the 8th day of June 1964, I surveyed the property shown on this plat, being known as lot 15 and a greater portion of lot 16 and a portion of lot 17 on plat of HILLSIDE HEIGHTS, recorded in R.M.C. Office Greenville County, S.C. in plat book "F" page 100, and also being known as Property of Marie P. Bradley recorded in plat book FFF page 165; and that the property lines, walls and buildings are as shown hereon, and that the buildings located on said lot do not encroach or project on adjacent street or property, and that no adjacent buildings or walls encroach or project on said premises.

R. B. Bruce
R.B. Bruce, R.L.S. #1952

777-165

JUN 12 1964

35268

CAROLINA ENGINEERING & SURVEYING CO.
GREENVILLE, S.C.

35268 Filed This 12 day of June 1964
And Recorded in Vol. FFF Page 165 at 4:33 pM

Register Mesne Conveyance Greenville County, S. C.