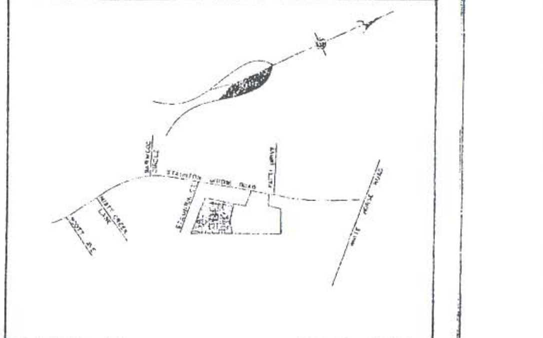

LOCATION MAP NOT TO SCALE

Preliminary
~~FINAL PLAT~~

CERTIFICATE OF OWNERSHIP AND DEDICATION

Signed *Ennis M. Fant*

Signed

Signed

Signed

CERTIFICATE OF ACCURACY

S.C. Registration No.

CERTIFICATE OF APPROVAL FOR RECORDING

05-205
FILE NUMBER
~~87-164~~

STAUNTON PLACE

SECTION 2

ENNIS M. FANT
OWNER

DALTON & NEVES CO., INC.
ENGINEERS

NO. OF ACRES 5.30 MILES OF NEW ROAD .01

NO. OF LOTS 17 DATE NOVEMBER, 1987

ZONED R-10

SCALE: 1" = 50'

50 0 50 100