


Greenville, S.C. Council
J.O. 53-2371-R
Code 9-C. Mrs. Clinton

Toll Line _____ (Name)
Or Exchange Line _____ (Exchange)
tributary to _____
The Property is bounded where the line enters and leaves this property by the property of:
Clara M. Pearty on the S and
Lola Bicknell on the W

Number of poles covered by this permit 1
Number of Guys and Anchors _____
The poles have the following numbers:
from No. _____ to No. _____

Poles are located on private property and in Streets and Highways as shown on the following diagram.

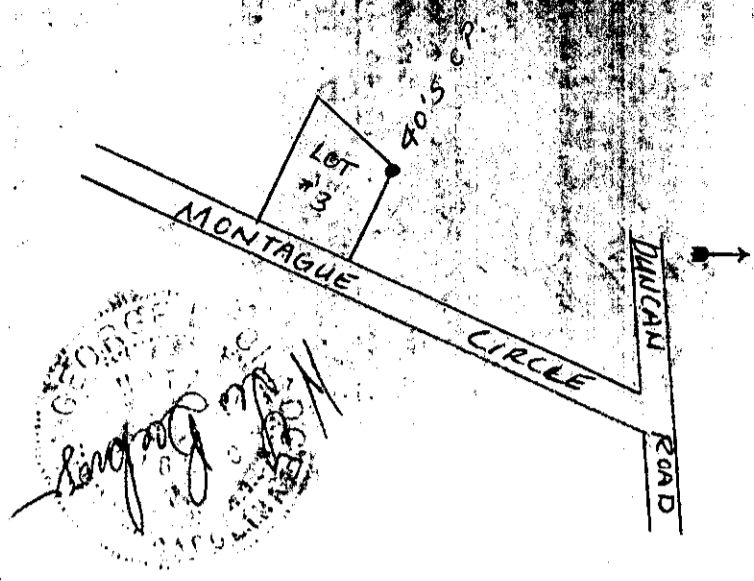

NOV 27 1955 30827

Form 6106 (Sept., '48)

GENERAL PERMIT

\$ 1.00 Received of the SOUTHERN BELL TELEPHONE AND TELEGRAPH COMPANY, (INCORPORATED)

One and 00/100 Dollars in consideration of which I hereby grant unto said Company, its associated and allied companies, their respective successors and assigns, the right, privilege and authority to construct, operate and maintain its lines of Telephone and Telegraph, and for the general transmission of intelligence, consisting of such poles, wires, cables, conduits, guys, anchors and other fixtures and appurtenances as the grantee may from time to time require, upon, across, over and/or under the property which I own or in which I have any interest in the County of Greenville and State of S.C. and upon, along and/or under the roads, streets, or highways adjoining the said property, and the right to permit the attachment of and/or carry in conduit wires and cables of any other company or person, and with the further right to trim and cut down and to keep trimmed and cut down all trees and undergrowth within 10 feet of said line, and in addition thereto, the grantee shall have the right to cut down, from time to time, all dead, weak, leaning or dangerous trees that are tall enough to reach the wires in falling; said sum being received in full payment for the rights herein granted.

Lot 3 in Montague Circle located off Duncan Road.

Witness my hand and seal this 31 day of October 19 55 at Greenville S.C. (Post Office Address)

Witness John E. Simkins Virginia Pinkins (L.S.)
D.B.ripp VIRGINIA SIMKINS (Land Owner) (L.S.)

STATE OF SOUTH CAROLINA
COUNTY OF GREENVILLE

Personally appeared before me D.B.ripp and Virginia Simkins made oath that she saw the within instrument, that she is the within instrument, and John E. Simkins witnessed the execution

Recorded November 29th 1955 at 10:43 A.M. #30827