BOOK 622 PAGE 186

Name and Post Office Address of Grantor: Selan Harris, R.F.D. #4, Greenville, S.C.

Toll Line { (Name)

Or Exchange Line tributary to { Greenville (Exchange)

The Property is bounded where the line enters and leaves this property by the property of: Mrs. Martha Brown on the W and F.C. Pickens on the E

The poles (or stakes) have the following identification: See Drawing Below

Authority 93-173 Classification

Area Greenville S.C.

Approved W.E. Lazar

Title Engineer

NORTH

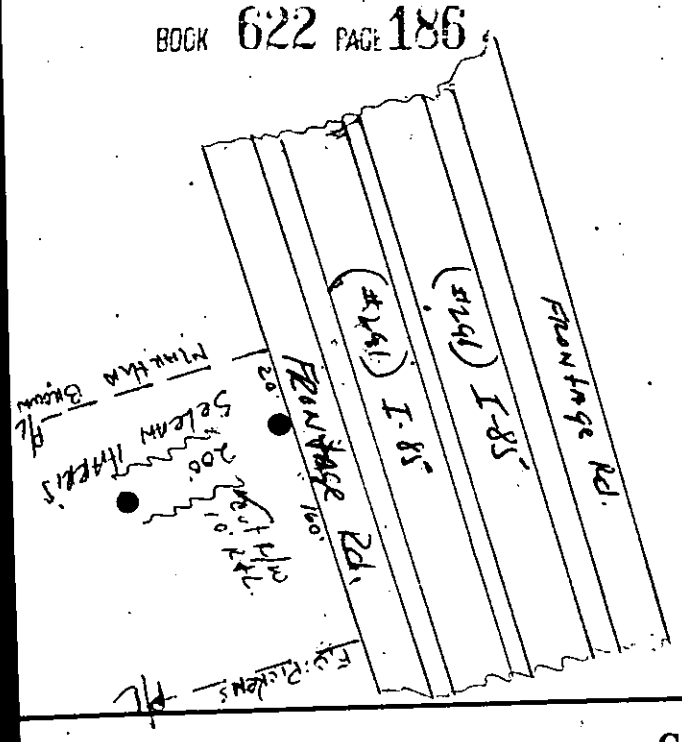

GEP 47.101

GENERAL PERMIT

(INDIVIDUAL)

Form 8416 Nov. '54

One X no/100

Received of the SOUTHERN BELL TELEPHONE AND TELEGRAPH COMPANY Dollars in consideration of which (I) ~~(we)~~ hereby grant said Company, its associated and allied companies, their respective licensees, successors and assigns, the right to construct, operate and maintain a line of communication consisting of such poles, wires, cables, conduits, guys, anchors and other necessary appurtenances as from time to time are required upon, across, over and/or under that certain tract of land situated in Greenville County, State of South Carolina, to-wit: Bounded on the West by Martha Brown and on the East by F.C. Pickens.

and upon, along and under the roads, streets, or highways adjoining or through said property with the right to permit the attachment of and/or carry in conduit wires and cables of any other person or company for communications purposes or for the transmission and distribution of electric power and the right of ingress and egress to said premises at all times for the purpose of inspecting and maintaining said line and with the right to clear and keep cleared all trees, undergrowth or other obstructions within a strip of land 10 feet on each side of the center of said line and to trim and cut and keep trimmed and cut all dead, weak, leaning or dangerous trees which might reach said line in falling; including the right to relocate said line on said premises to conform to any future highway relocation, widening or improvement; the said sum being received in full payment for the rights herein granted.

Signed, sealed and delivered in the presence of:
W. E. Lazar
H. L. Calloway

Executed February 24, 1959
Selan Harris (SEAL)
(SEAL)

GEP 47.101

Form 8425 Nov. '54

ACKNOWLEDGMENTS

For Use in South Carolina

Individual Form

STATE OF SOUTH CAROLINA
COUNTY OF Greenville } SS.

Personally appeared before me W. E. Lazar Jr. and made oath that (he) ~~(she)~~, with H. L. Calloway saw the within named Selan Harris sign, seal, and deliver as ~~(his)~~ (her) ~~(their)~~ act and deed the within written instrument, and that (he) ~~(she)~~ with the said H. L. Calloway witnessed the execution thereof.

W. E. Lazar Jr.

Sworn to before me this 24 day of Feb. A.D. 1959

Notary Public

Recorded April 23, 1959 at 9:27 A. M.
#27721