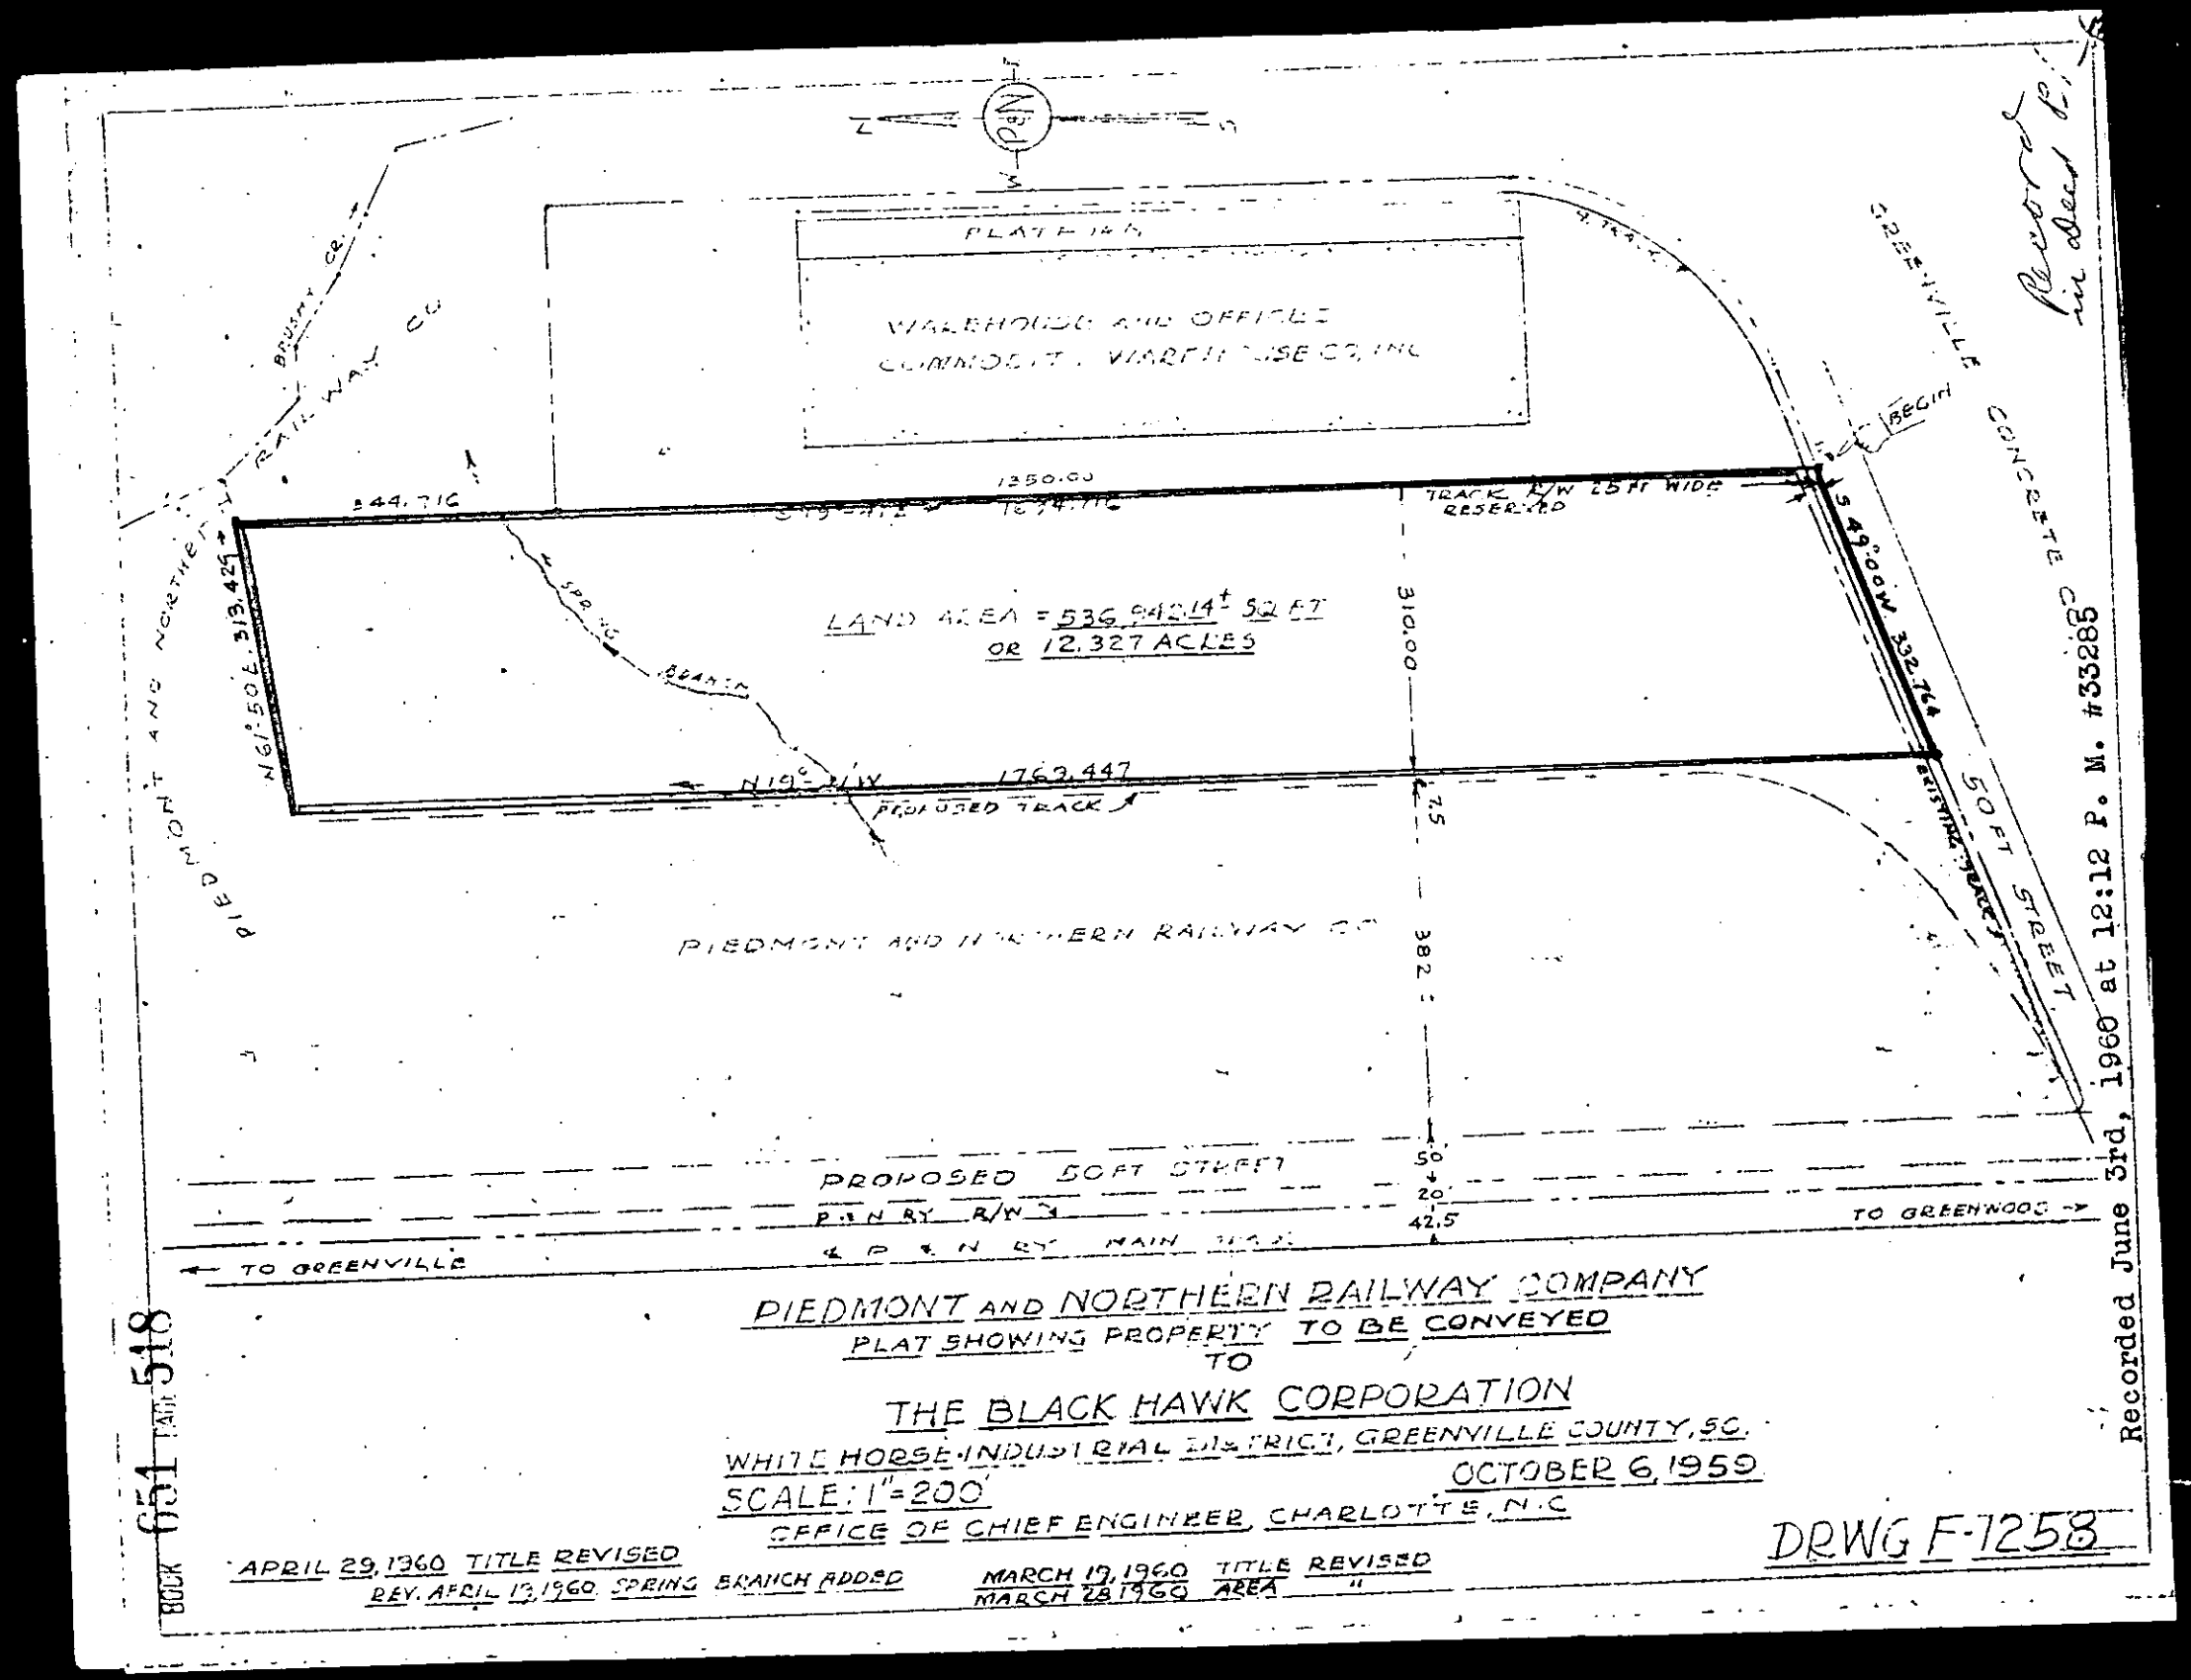

PIEDMONT AND NORTHERN RAILWAY COMPANY
PLAT SHOWING PROPERTY TO BE CONVEYED
TO
THE BLACK HAWK CORPORATION
WHITE HORSE INDUSTRIAL DISTRICT, GREENVILLE COUNTY, S.C.
SCALE: 1" = 200'
OCTOBER 6, 1959
OFFICE OF CHIEF ENGINEER, CHARLOTTE, N.C.

APRIL 29, 1960 TITLE REVISED
REV. APRIL 13, 1960 SPRING BRANCH ADDED
MARCH 17, 1960 TITLE REVISED
MARCH 28, 1960 AREA "

DRWG F-1258

Recorded June 3rd, 1960 at 12:12 P. M. #33285

BOOK 651 PAGE 518