
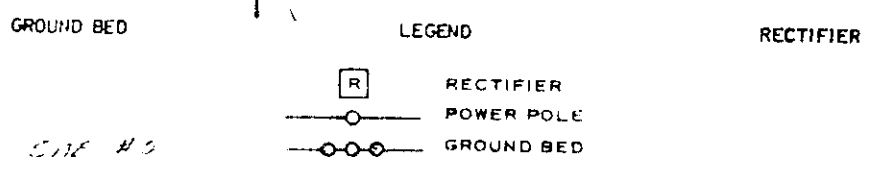


50,000 O-CM SOIL

BOOK 739 PAGE 59

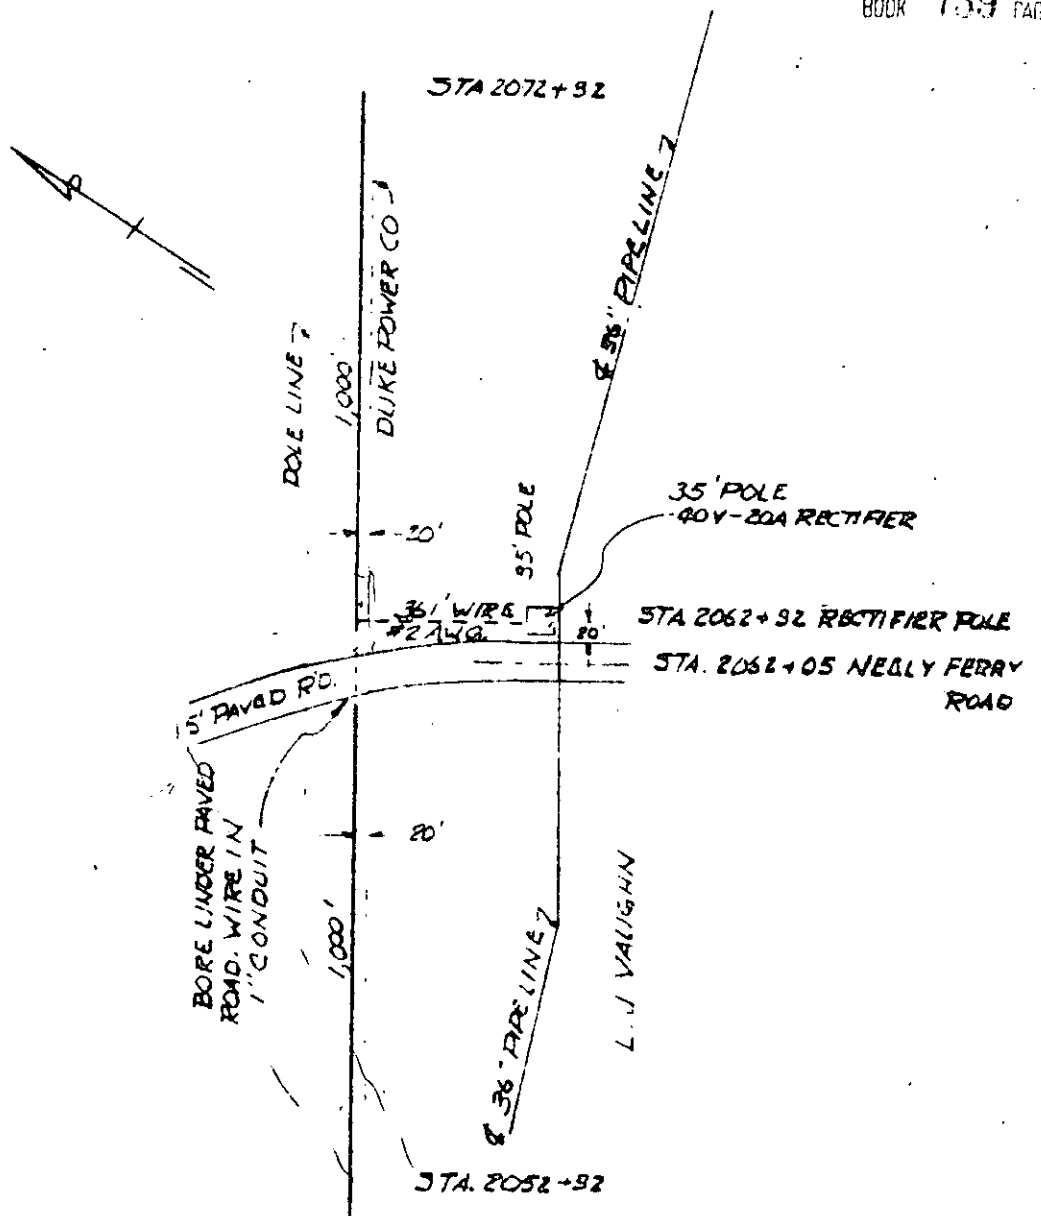

SITE # 5
 (ROSSON-RICHARDS - 94)

Recorded December 31, 1963 At 9:30 A.M. # 18651

DIV. CENTRAL MAP NO. S. 880. 121 INSTALLED LINE HOUSTON-GREENSBORO 36" M.P. -2062+05 COUNTY GREENVILLE COUNTY STATE SC	COLONIAL PIPELINE COMPANY ATLANTA, GEORGIA	DATE 9-10-68
	CATHODIC PROTECTION SITE C. P. UNIT NO. _____	SCALE 1" = 500' 1, 900 95