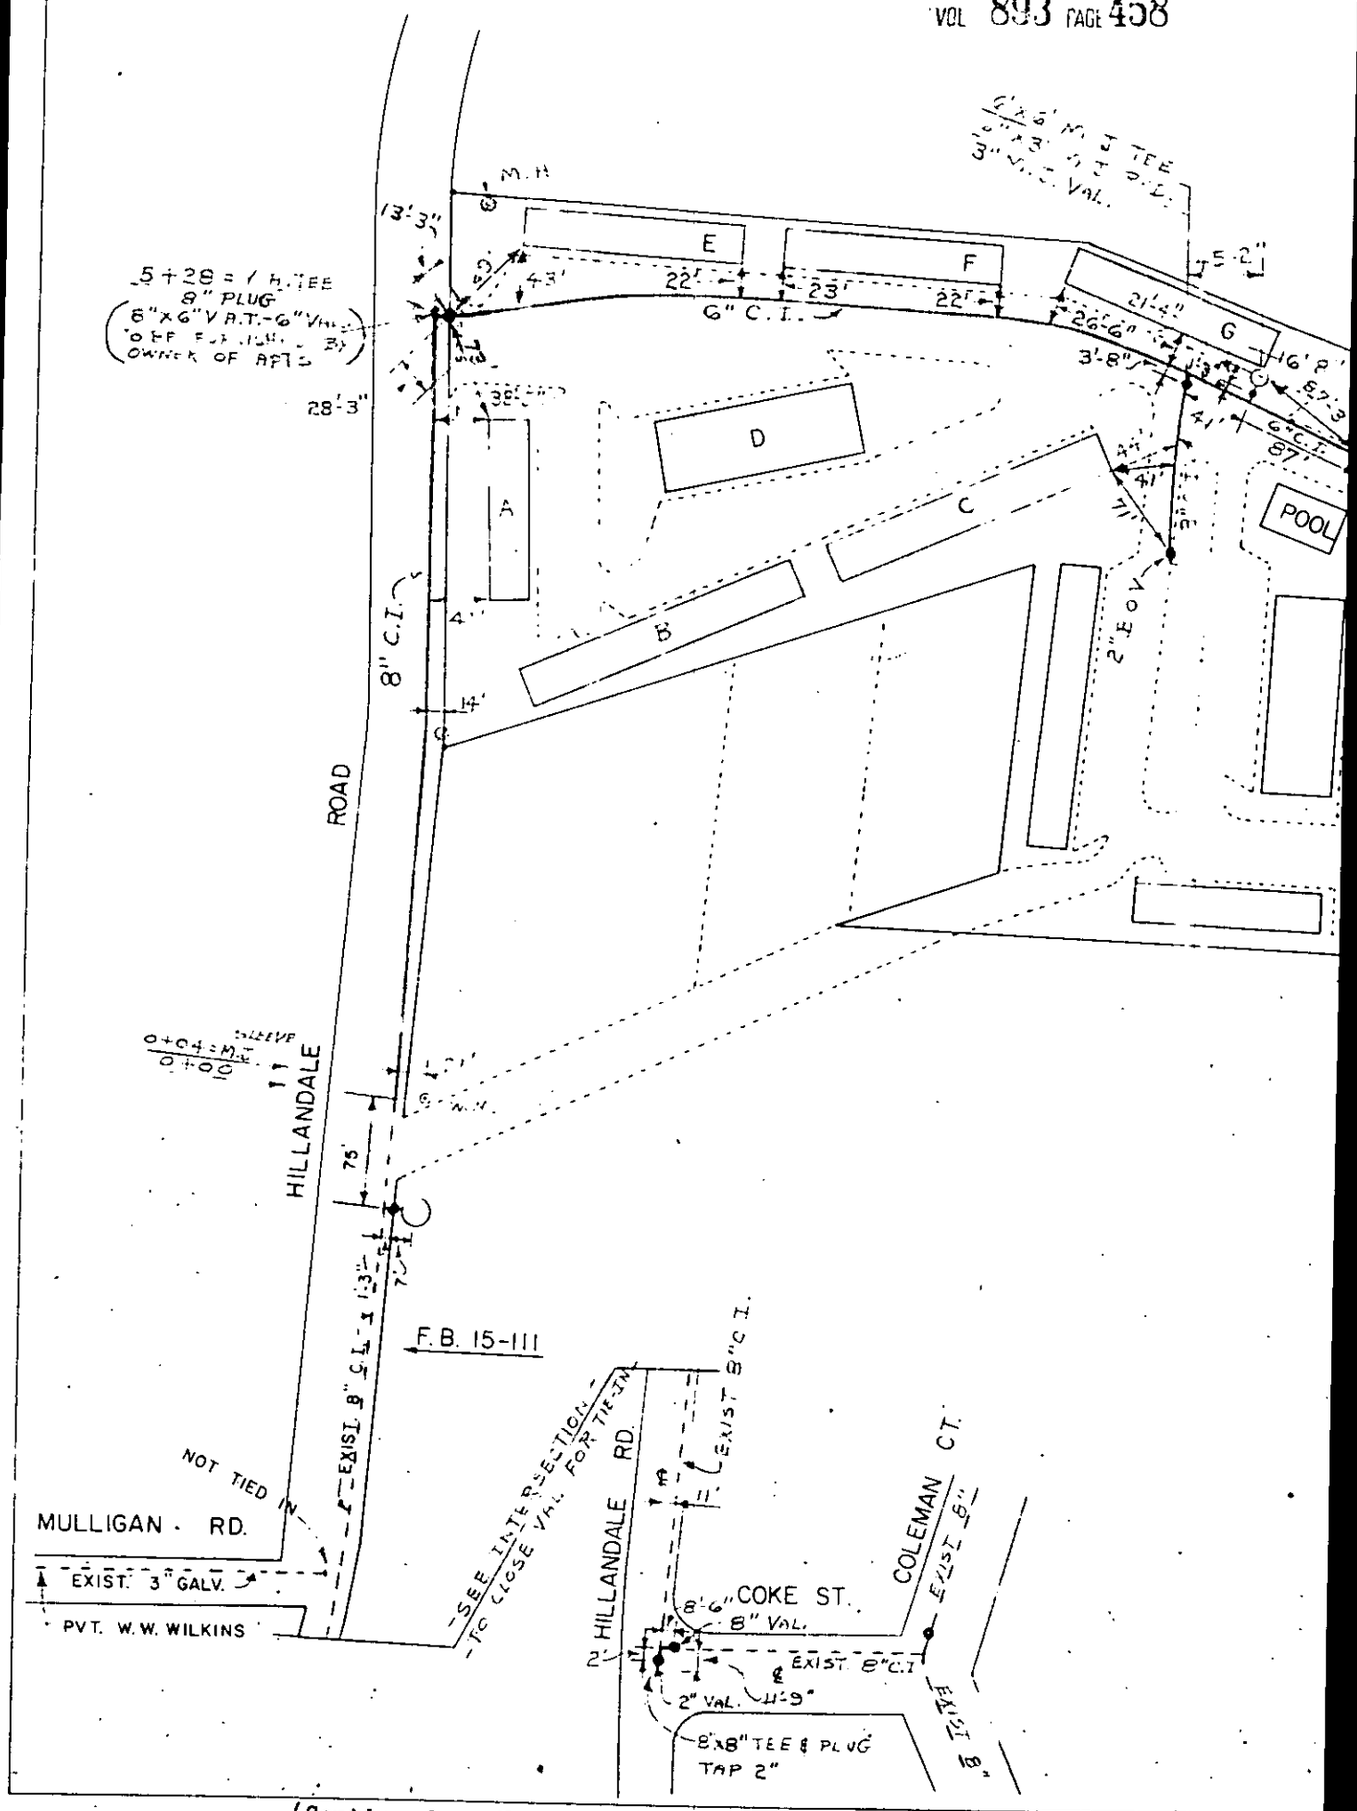

(Continued on Next Page)