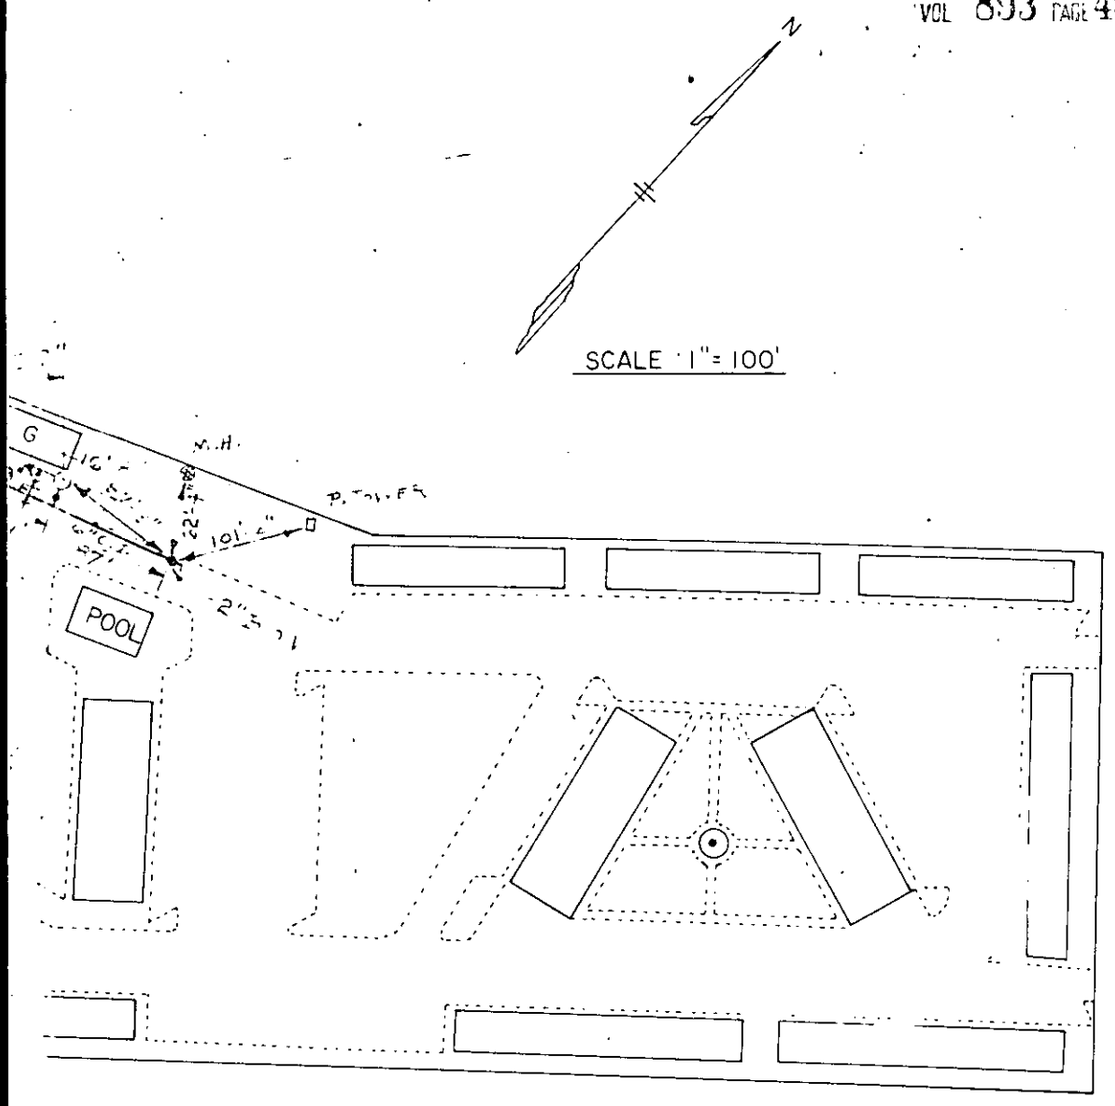

LA VISTA VILLA

JAN. 1970 BY L.N.M

EXT # 752

Recorded July 7th, 1970 at 3:50 P.M. #502