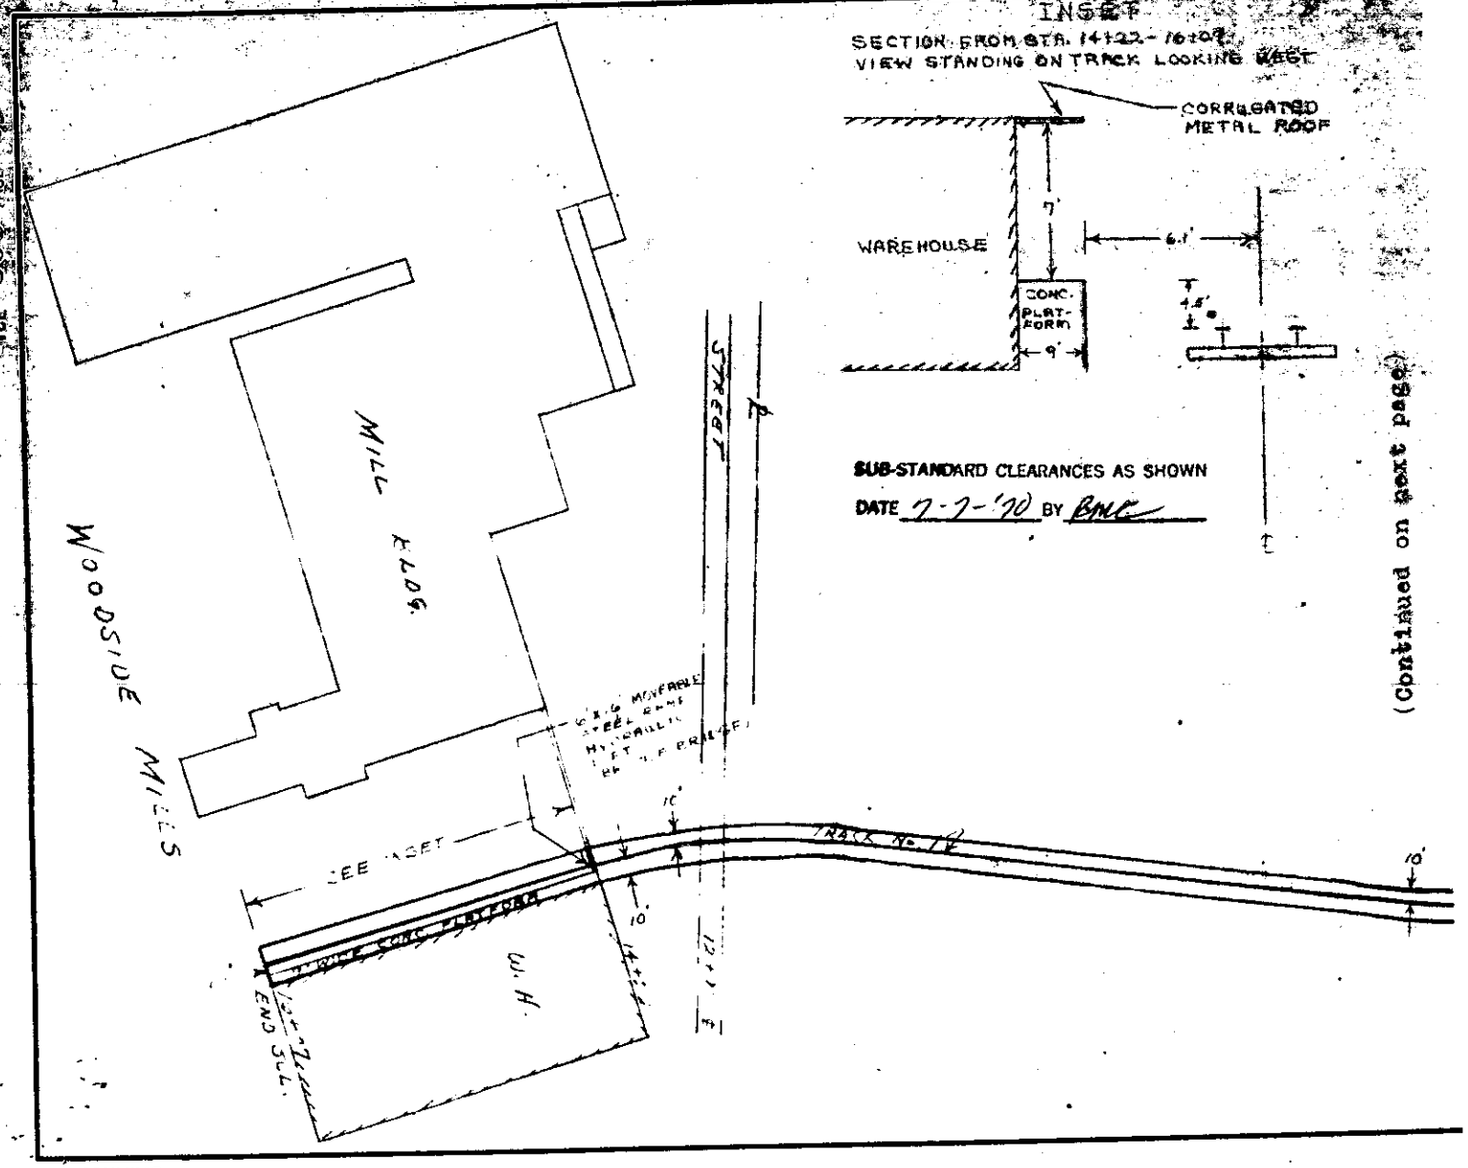

(Continued on next page)