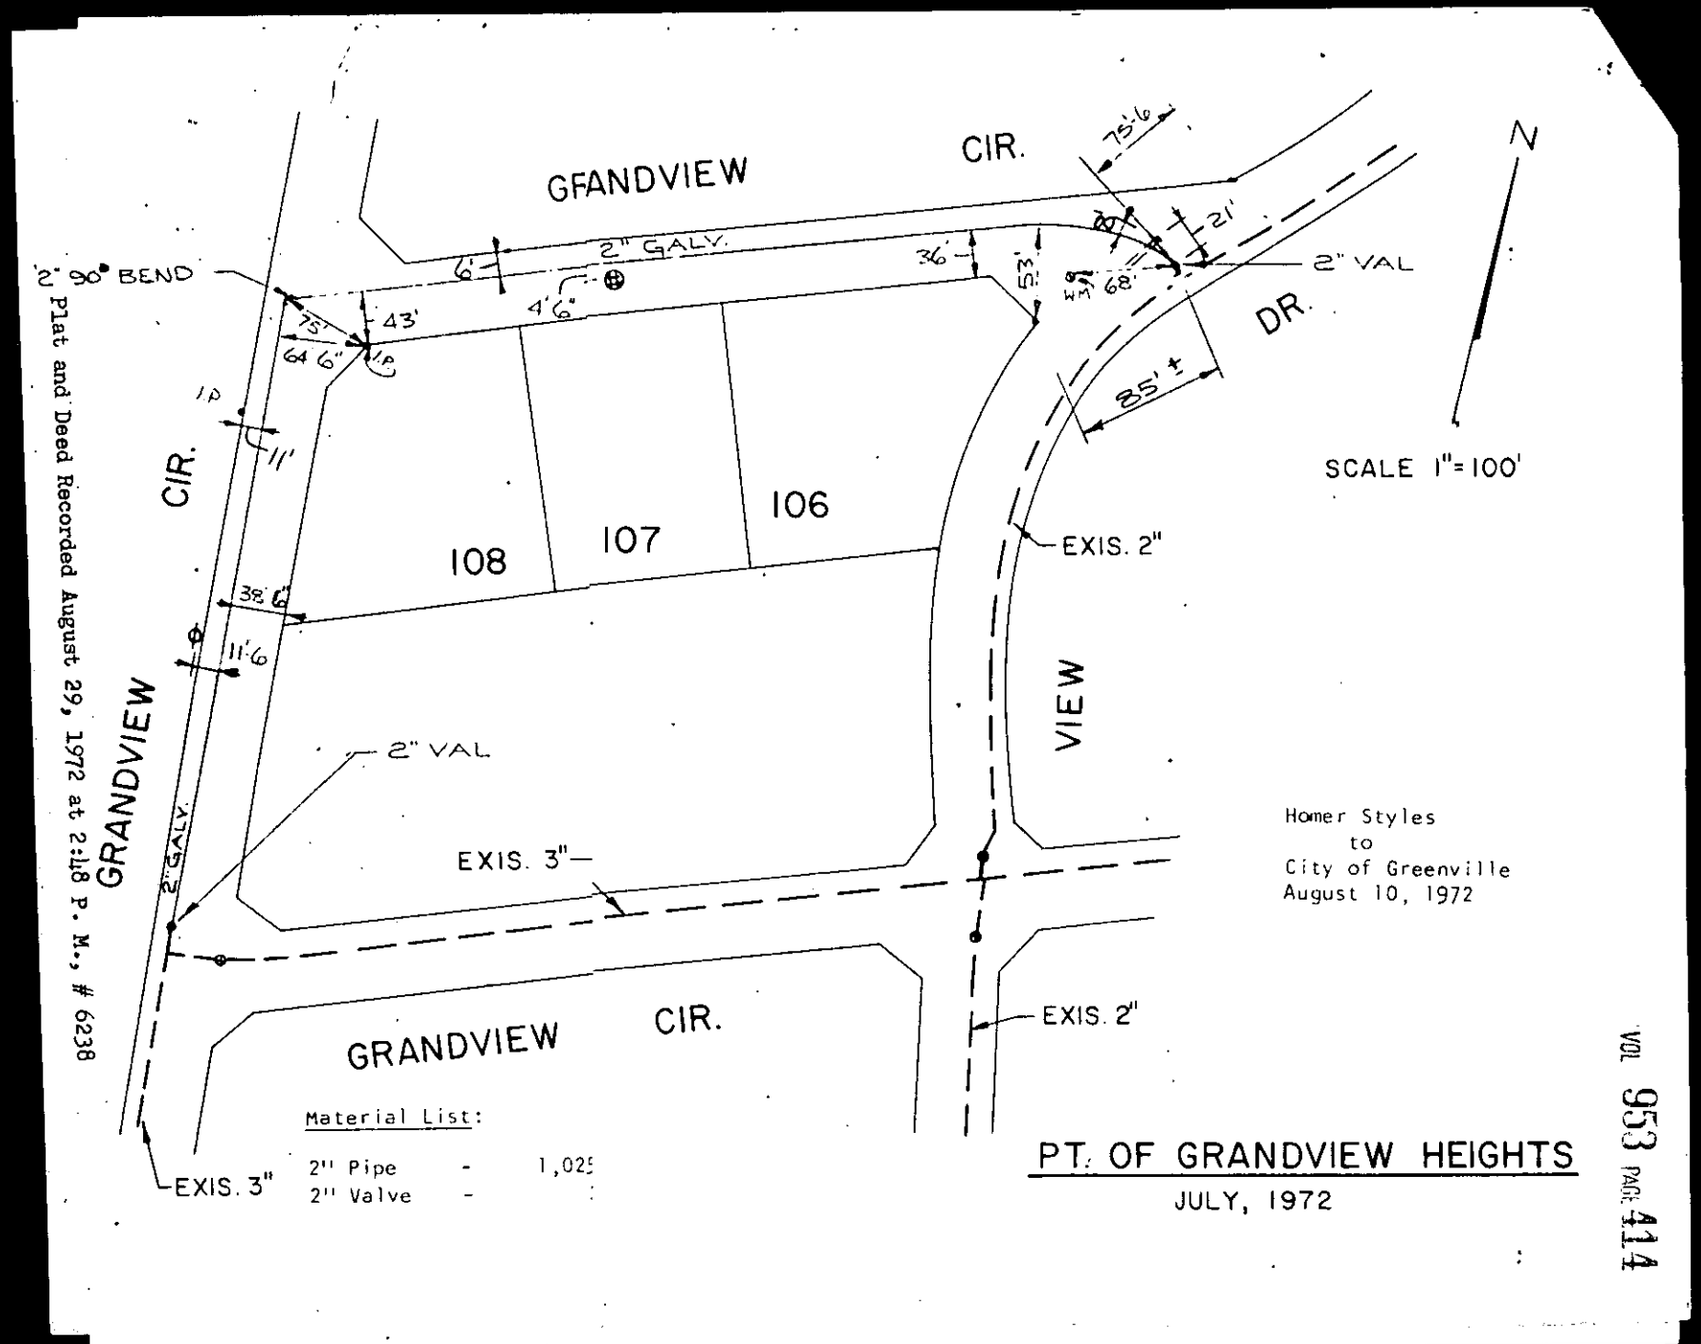

Homer Styles
to
City of Greenville
August 10, 1972

Material List:

2" Pipe	-	1,025
2" Valve	-	

PT. OF GRANDVIEW HEIGHTS

JULY, 1972

Plat and Deed Recorded August 29, 1972 at 2:48 P. M., # 6238

VOL 953 PAGE 414