
4 11

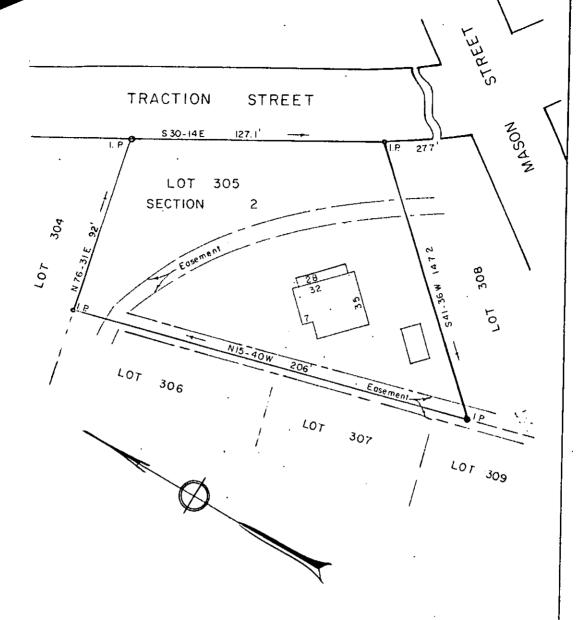

PROPERTY OF

JAMES E. MOYERS

GREENVILLE CO., S. C.

Scale I" = 40' April, 1971

This is to certify that on the 1st day of April, 1971, I surveyed the property shown on this plat; being known as Lot 305, Section 2 on plat of Abney Mills, Brandon Plant, Recorded in Plat Book QQ pages 56-59, Office of R. M. C. Greenville Co., S. C.; and that the property lines, walls and buildings are as shown hereon; that the buildings located on said lot do not encroach or project on adjacent streets or property; and that no adjacent buildings or walls encroach or project on said premises.

K. W. Daston

Dalton & Neves Co., Engineers

Plat Recorded January 2, 1973 at 2:43 P.M., # 18815

В. 393