0163

4328 RV.2

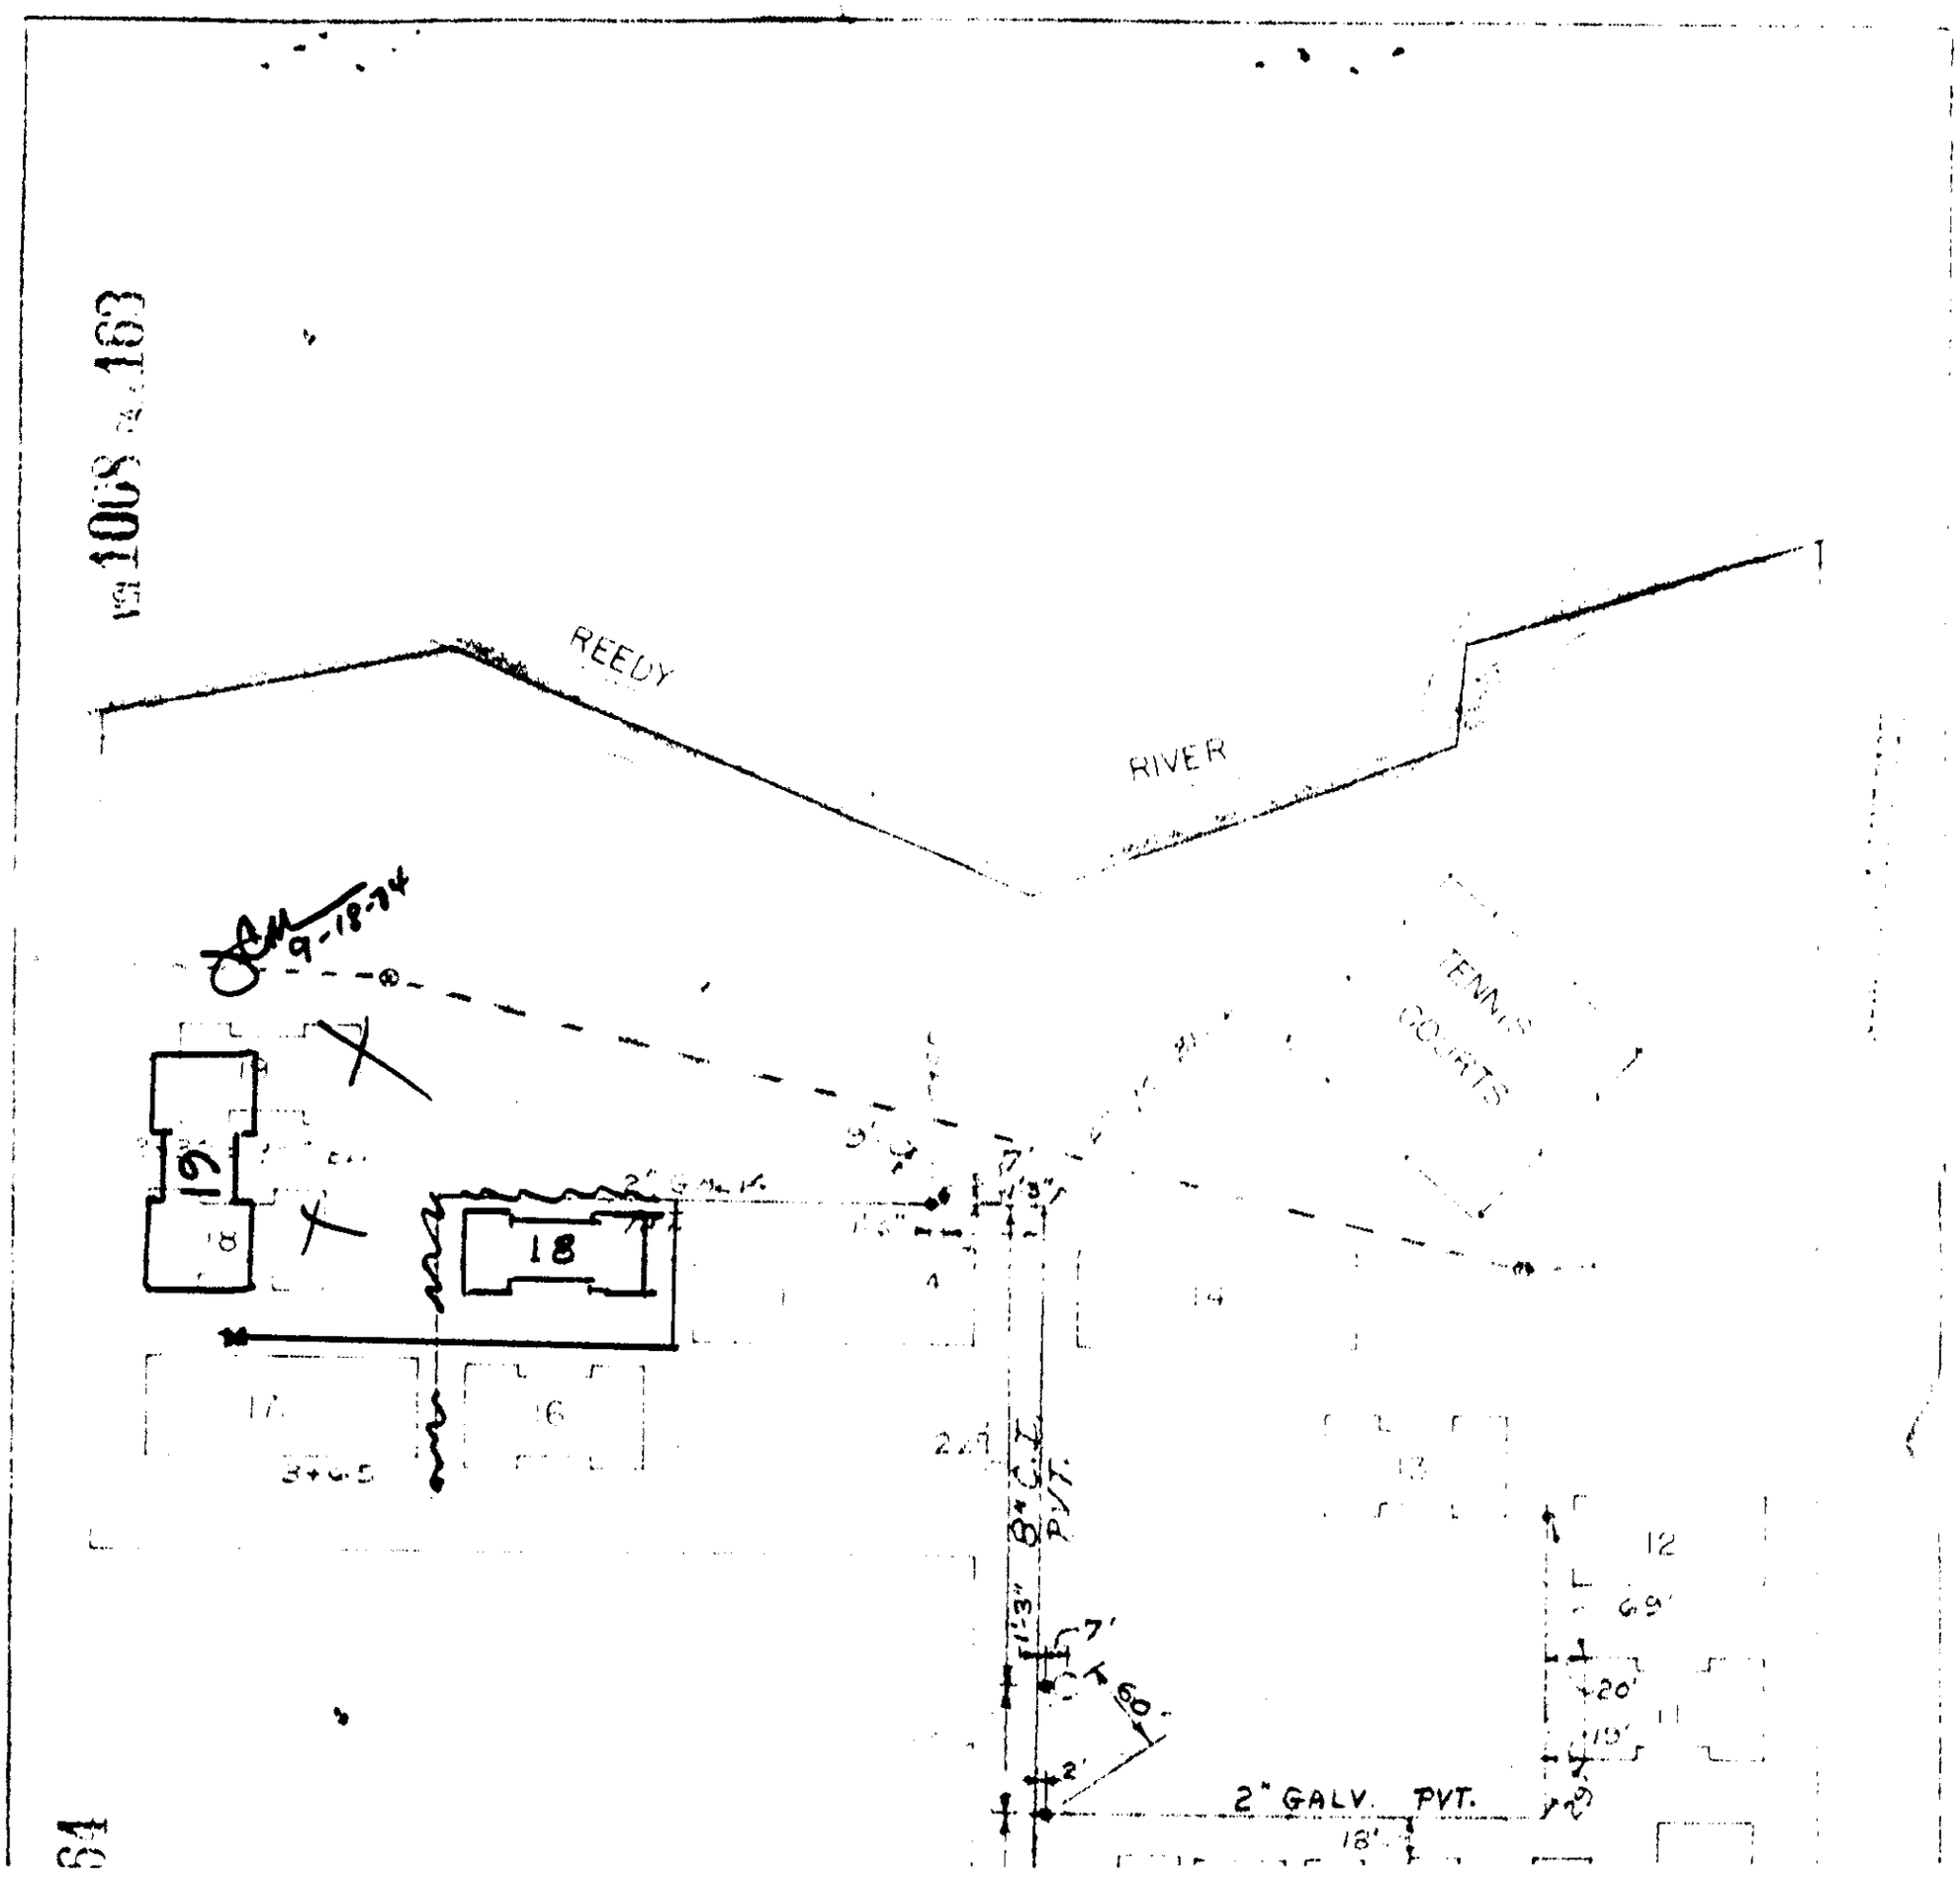

VOL 1068 PG 163