


Vol 1085 p. 85

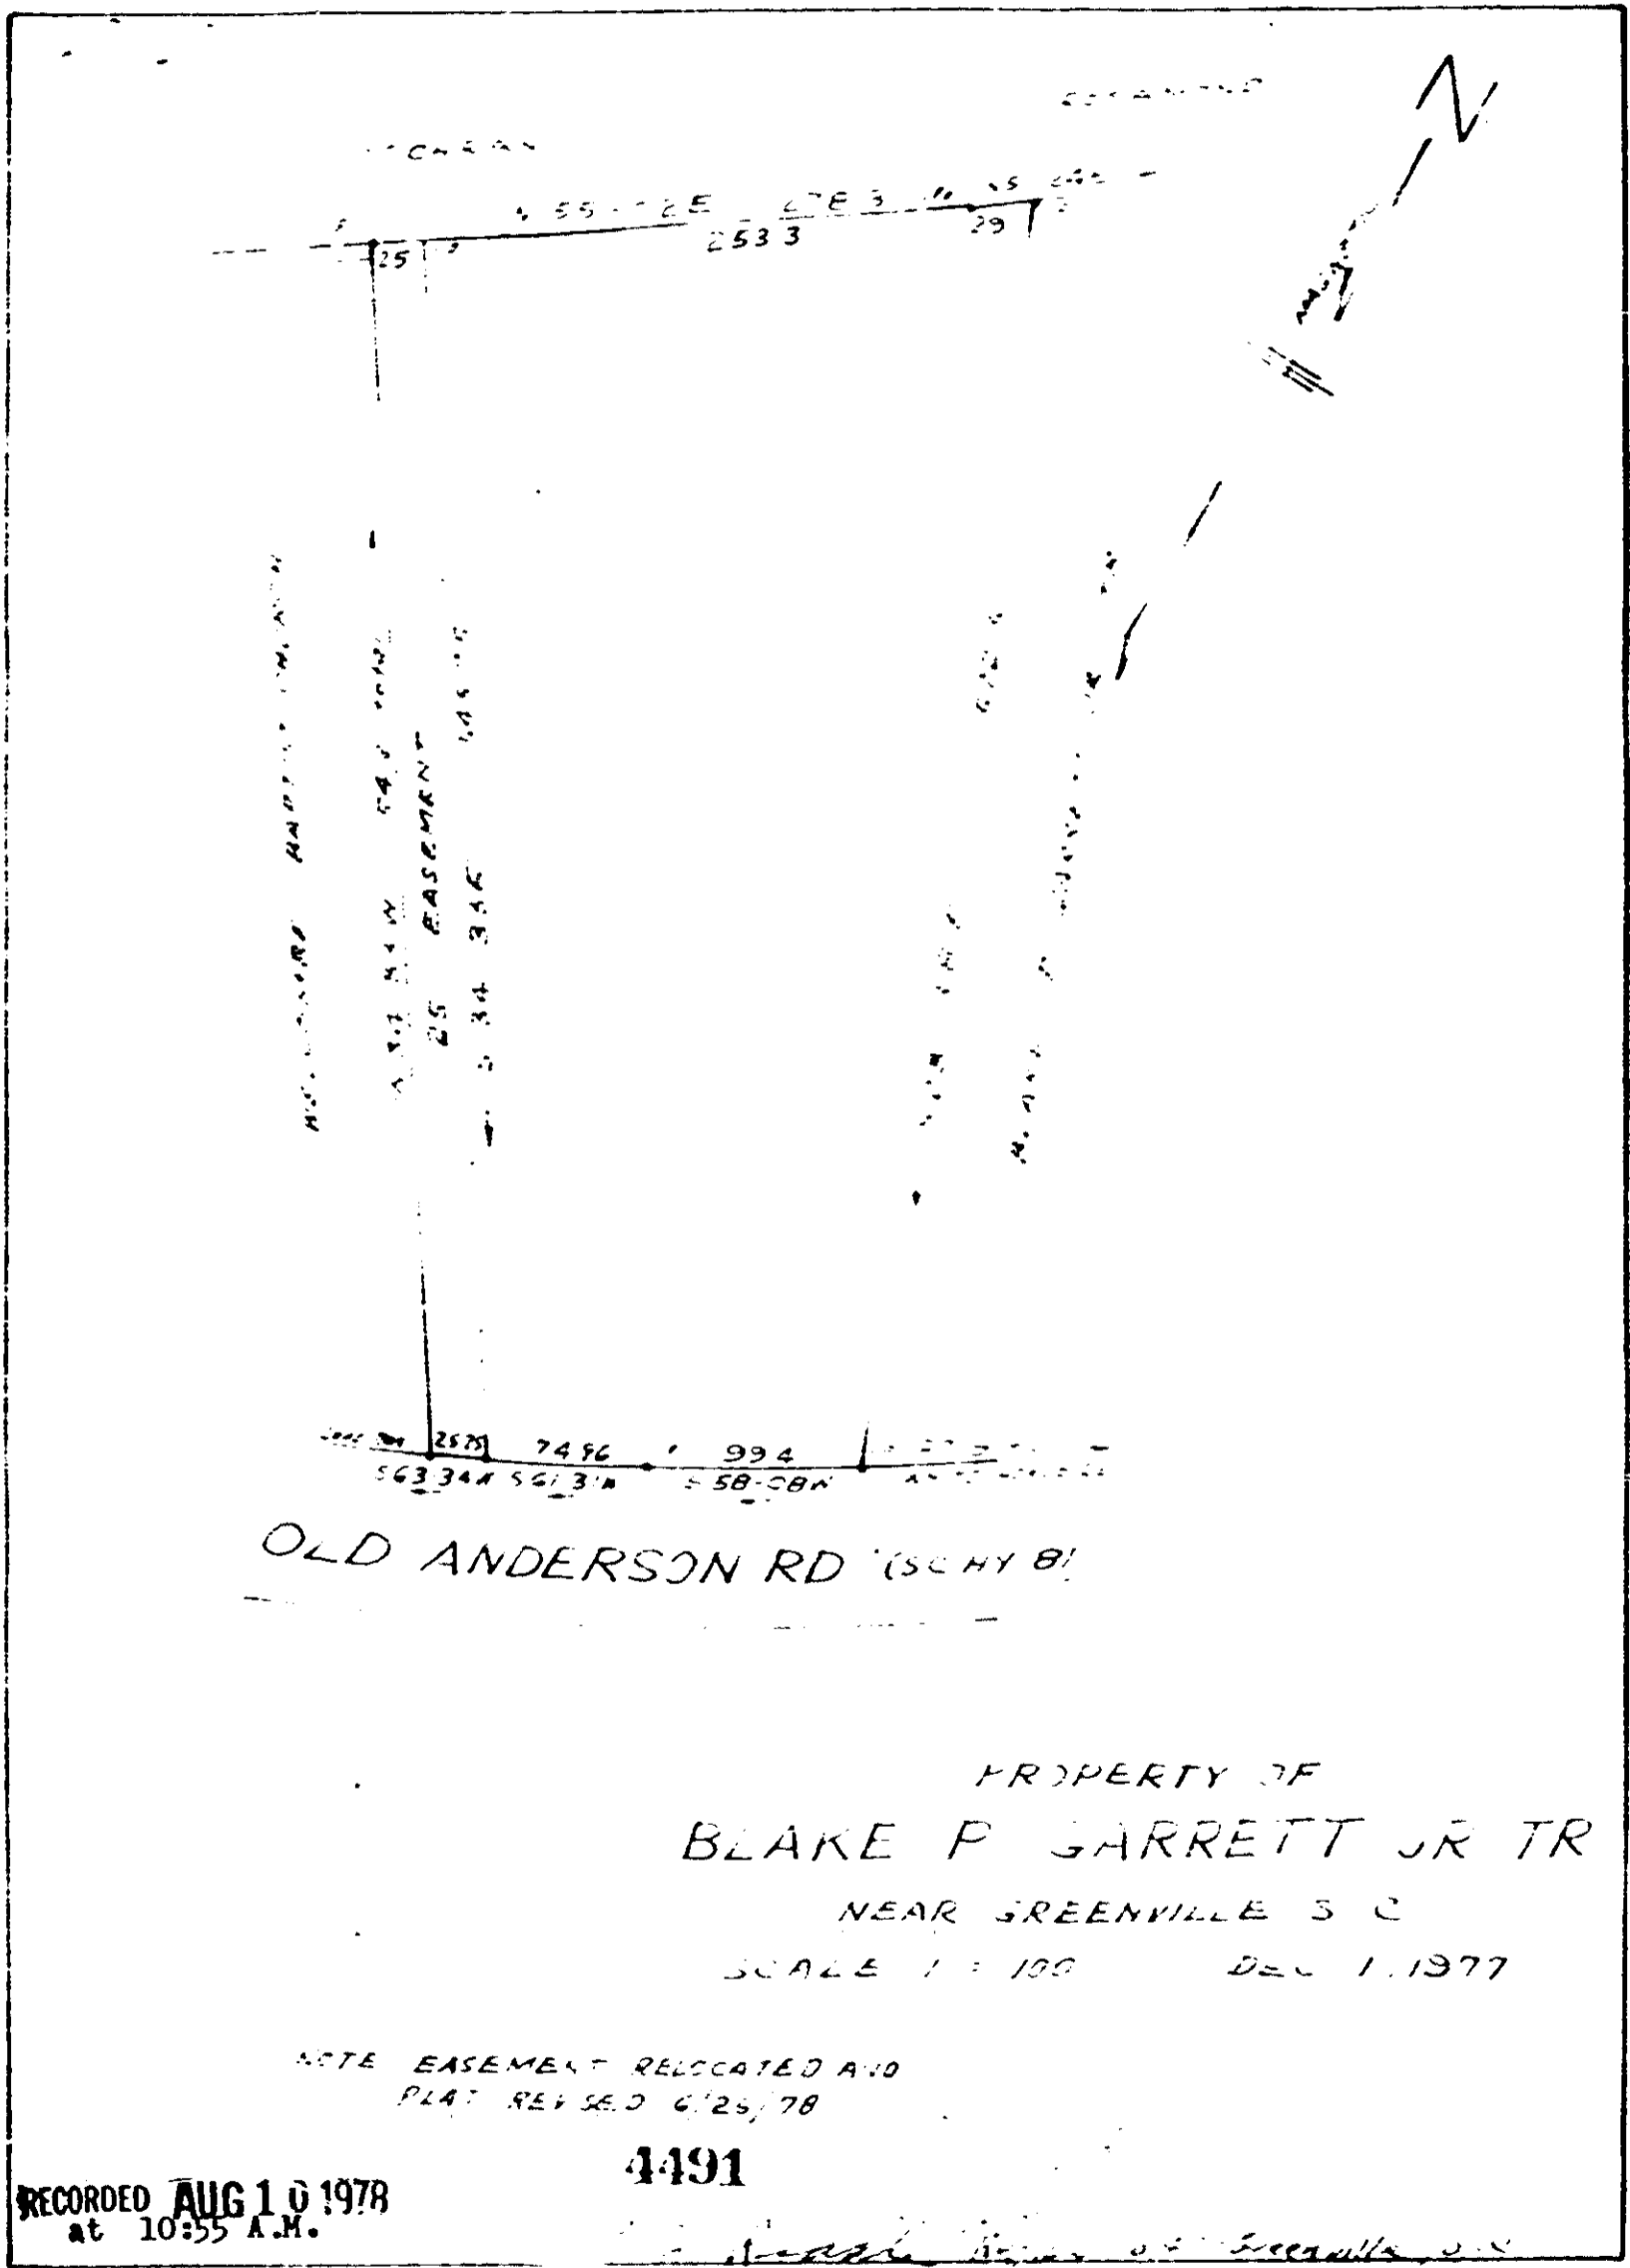

9085

4328 RV.2