EXHIBT "A" Davis Mechanical Site (not to indicated scale)

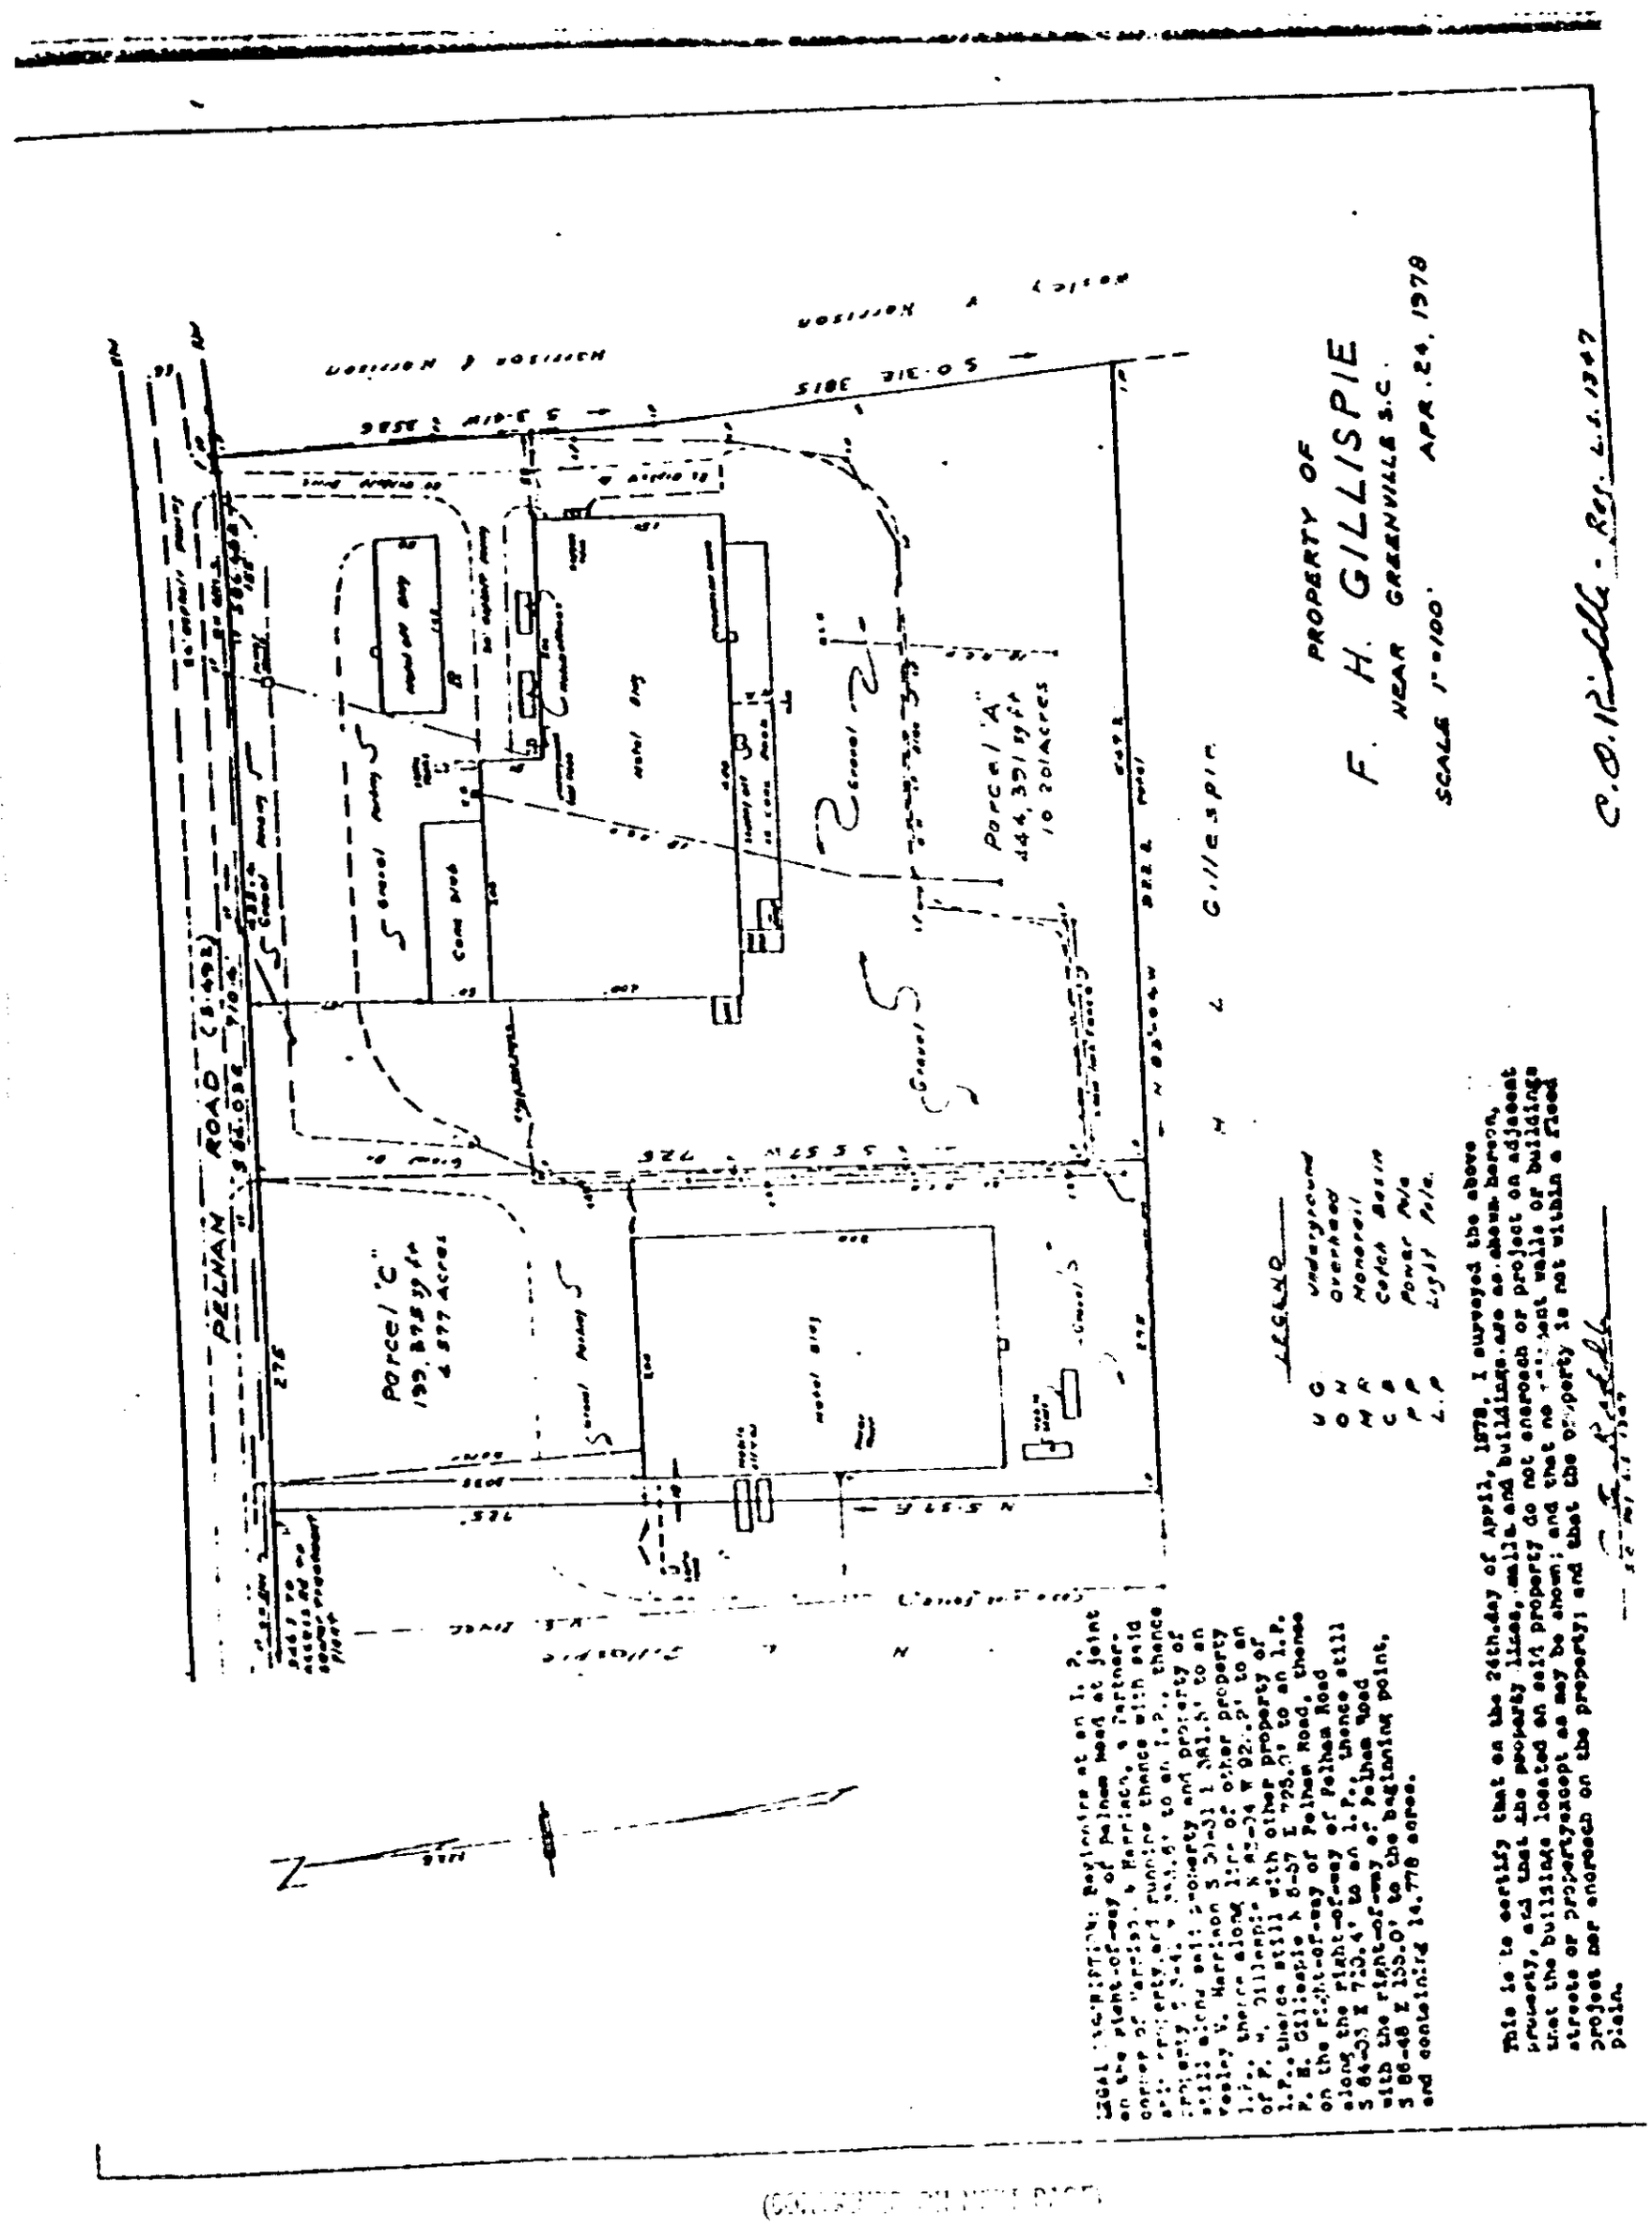

4328 RV-2