LIMITED COMMON ELEMENTS

VOL 1064 PAGE 551

VOL 1065 PAGE 423

Exhibit A

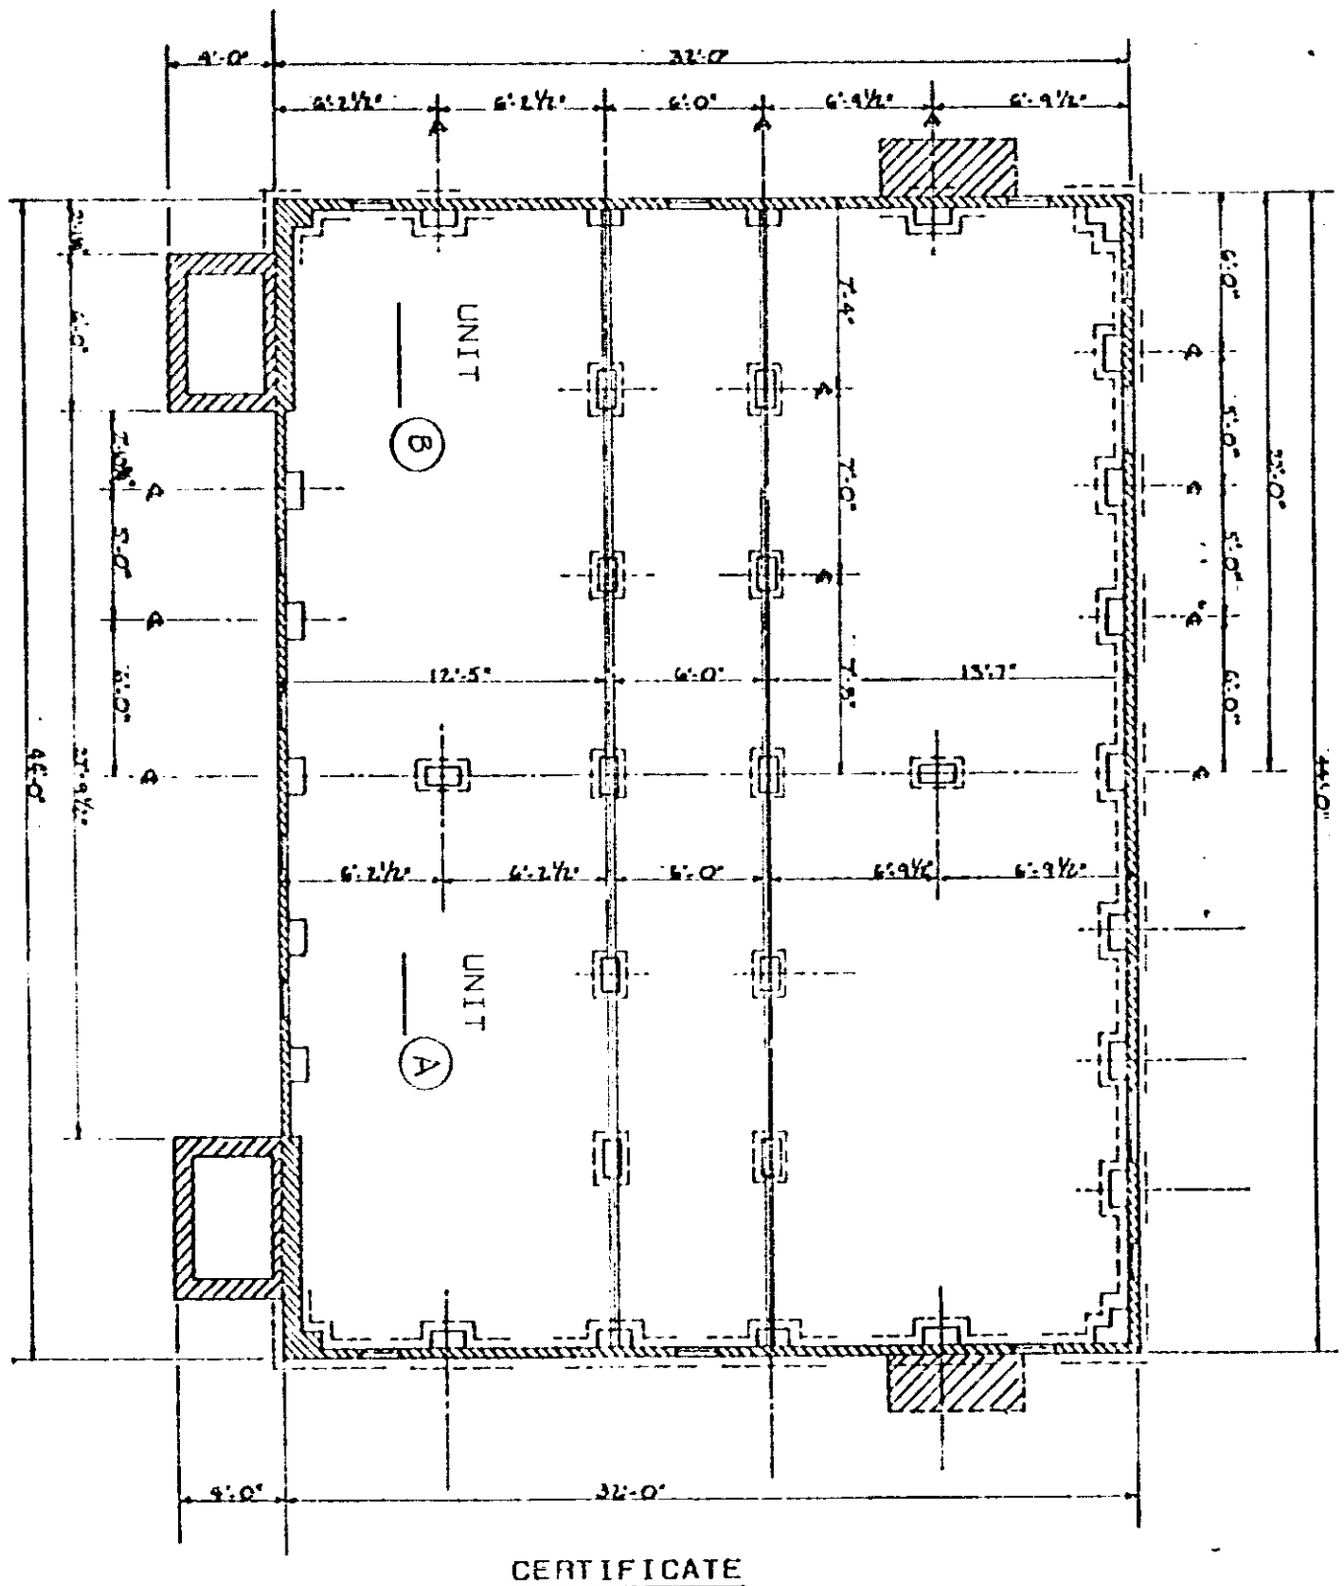

CERTIFICATE

I, Wade H. Barber, do hereby certify that these plans fully depict within reasonable construction tolerances the layout, location, letter identification and dimensions of the buildings and dwellings contained therein.

Wade H. Barber

REGISTERED ARCHITECT
WADE H. BARBER
No. 1516
STATE OF NORTH CAROLINA

0423

4328 RV-2