VOL 1098 PAGE 533

LIMITED COMMON ELEMENTS

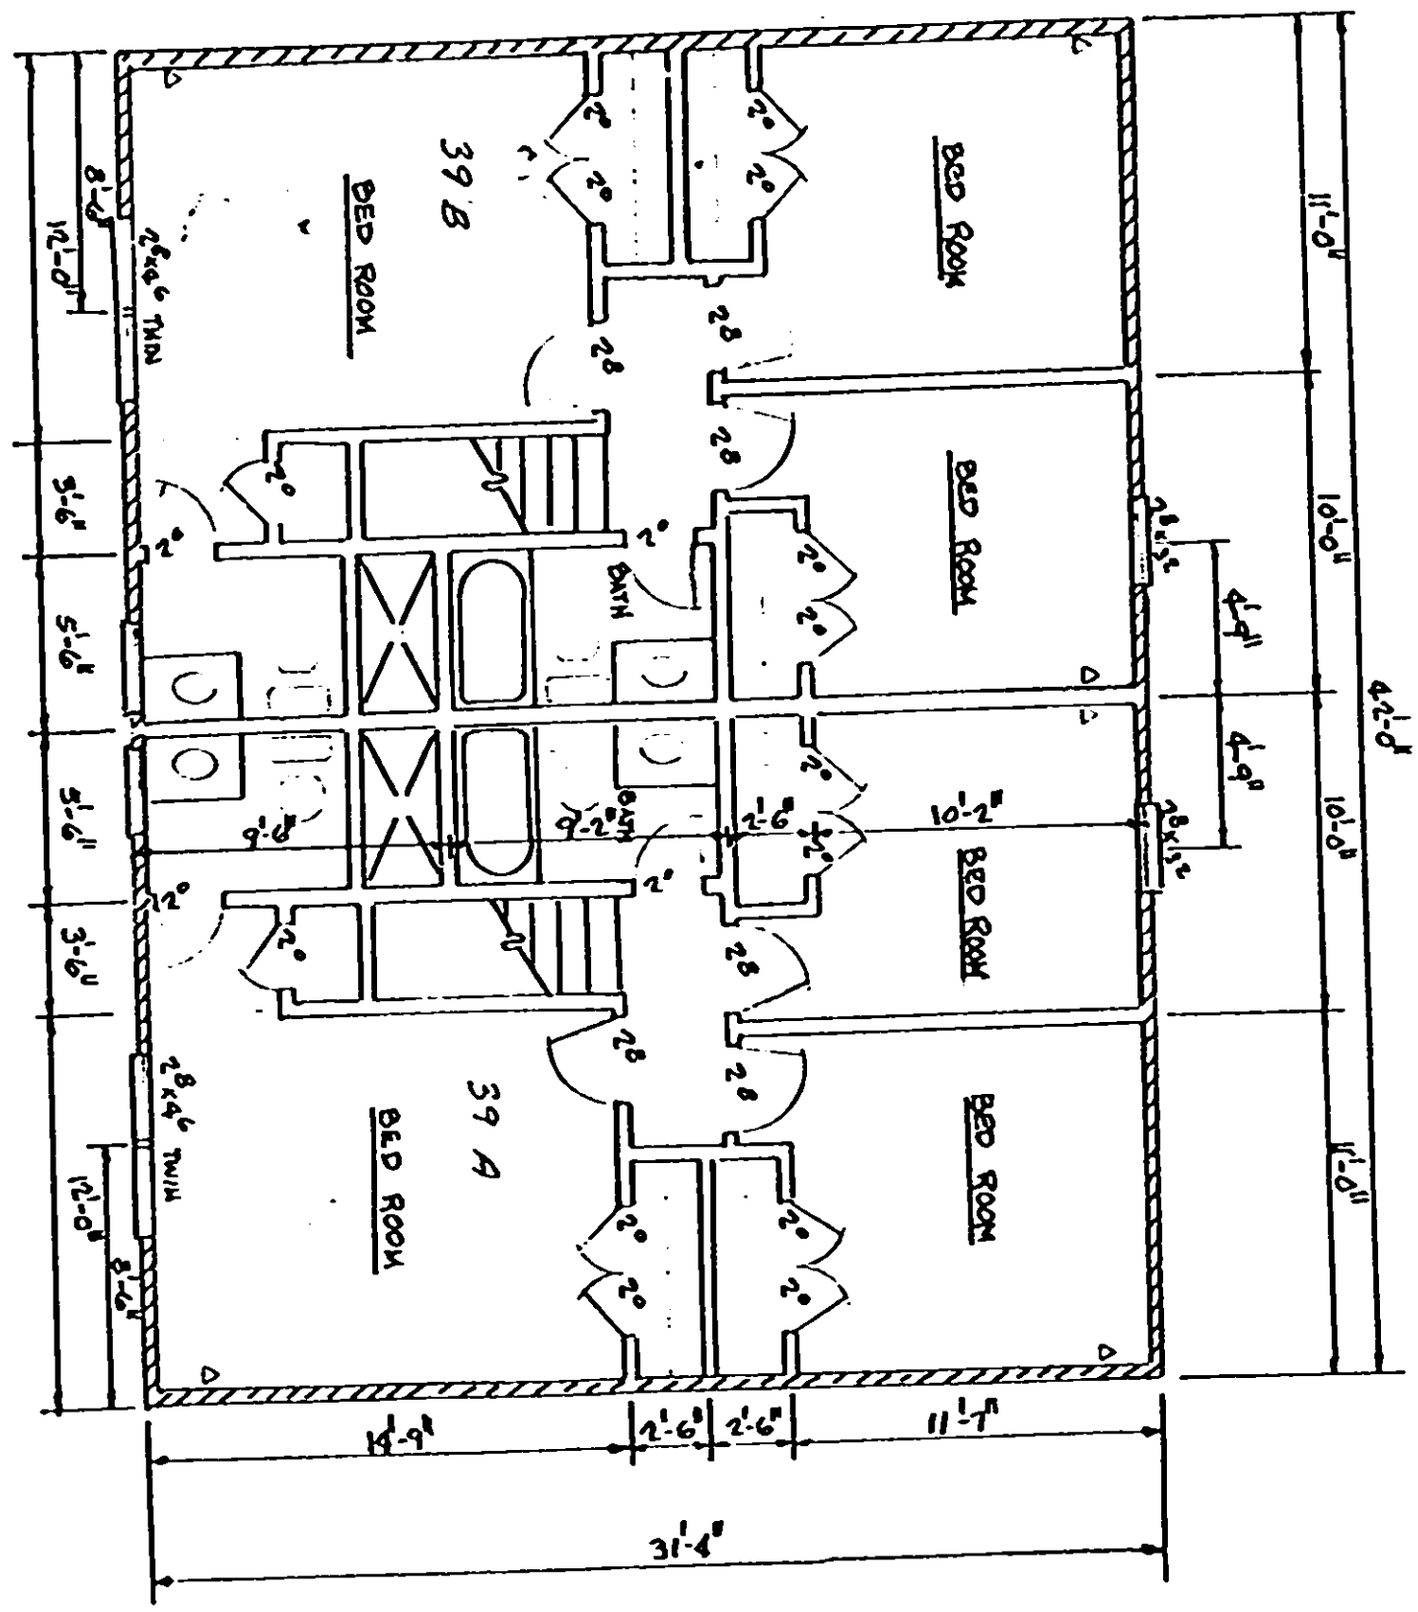

UPPER LEVEL FLOOR PLAN
SCALE: 1/8" = 1'-0"

CERTIFICATE

I, William D. Carroll, do hereby certify that these plans fully depict within reasonable construction tolerances the layout, location, letter identification and dimensions of the buildings and dwellings contained therein.

William D. Carroll

0533

4328 RV-2