

16030


4328 RV-2

EXHIBIT "B" (page 1)

BOOK 1121 PAGE 300

MAGNETIC NORTH

- NOTES:
1. All buildings' locations dimensions were measured to buildings.
 2. All interior widths to walls are 10 inches unless otherwise noted.
 3. Common walls -----
 4. Unit boundary -----
 5. Interior room elements // / / / /
 6. All roofed areas is covered but not paved.
 7. Foundation details to date from January 1980 and foundation details to date from January 1981.
 8. Approximate location of proposed buildings 12' 20" x 20' 0" and 21' 0" x 25' 0" from plan for Charles Gandy architect.
 9. Both walls completed or other areas bounded by the following dimensions:
 10. New architectural details for floor plans.
 11. Foundation 21' 0" x 21' 0" new construction.
 12. Foundation 23' 0" x 29' 0" new foundation in place.
 13. All dimensions refer to the measurement of public roads or the City of Greenville, S.C. for major lines.

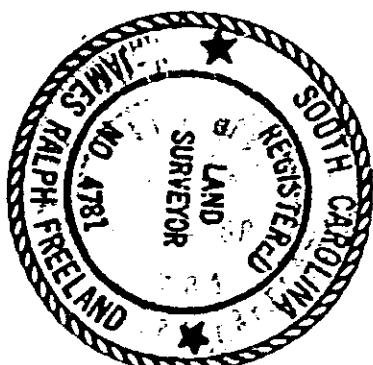

STATE OF SOUTH CAROLINA
GREENVILLE COUNTY
INGLESTIDE HORIZONTAL
PROPERTY REGIMENT
1981
REGISTRATION NO. 4781
RALPH FREELAND
SOUTH CAROLINA LAND SURVEYOR