


1121-361


EXHIBIT "B" (page 2)

NO. 206-210 FOUND. PLAN

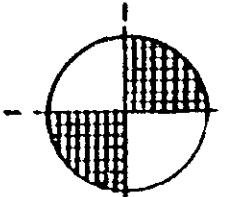

LIMITED COMMON ELEMENTS

GENERAL COMMON ELEMENTS

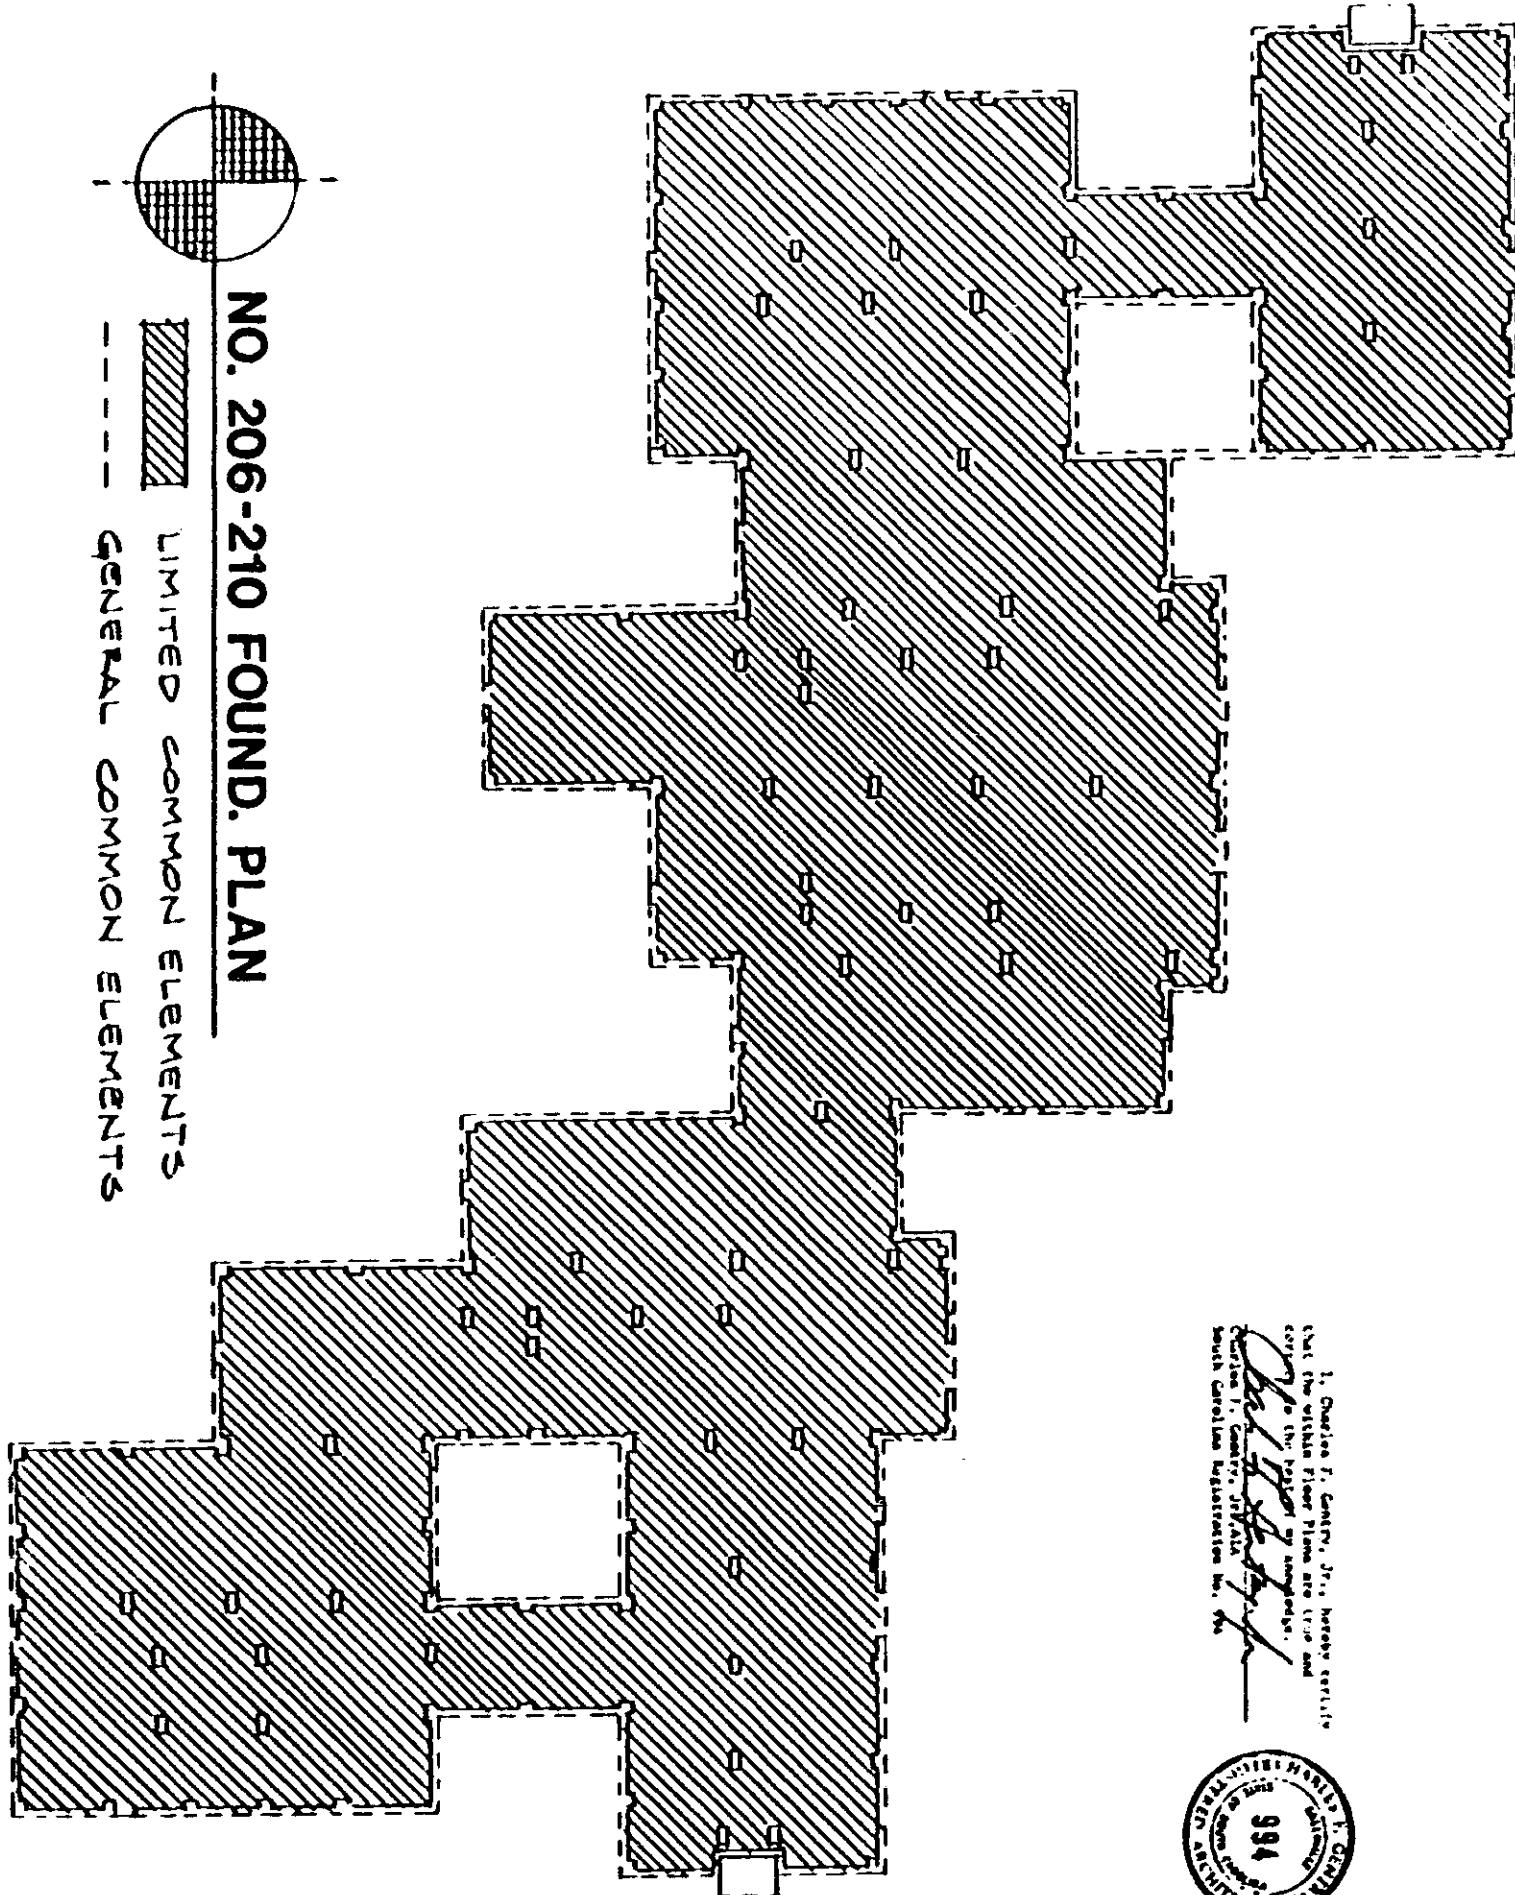

Charles F. Gentry, Jr., Horsley & Gentry
Architects, Inc.
Greenville, South Carolina
Architectural Registration No. 994



INGLESIDE HORIZONTAL PROPERTY REGIME

CHARLES F. GENTRY A.I.A. ARCHITECT

GREENVILLE

SOUTH CAROLINA

1-11-80

4328 RV-2