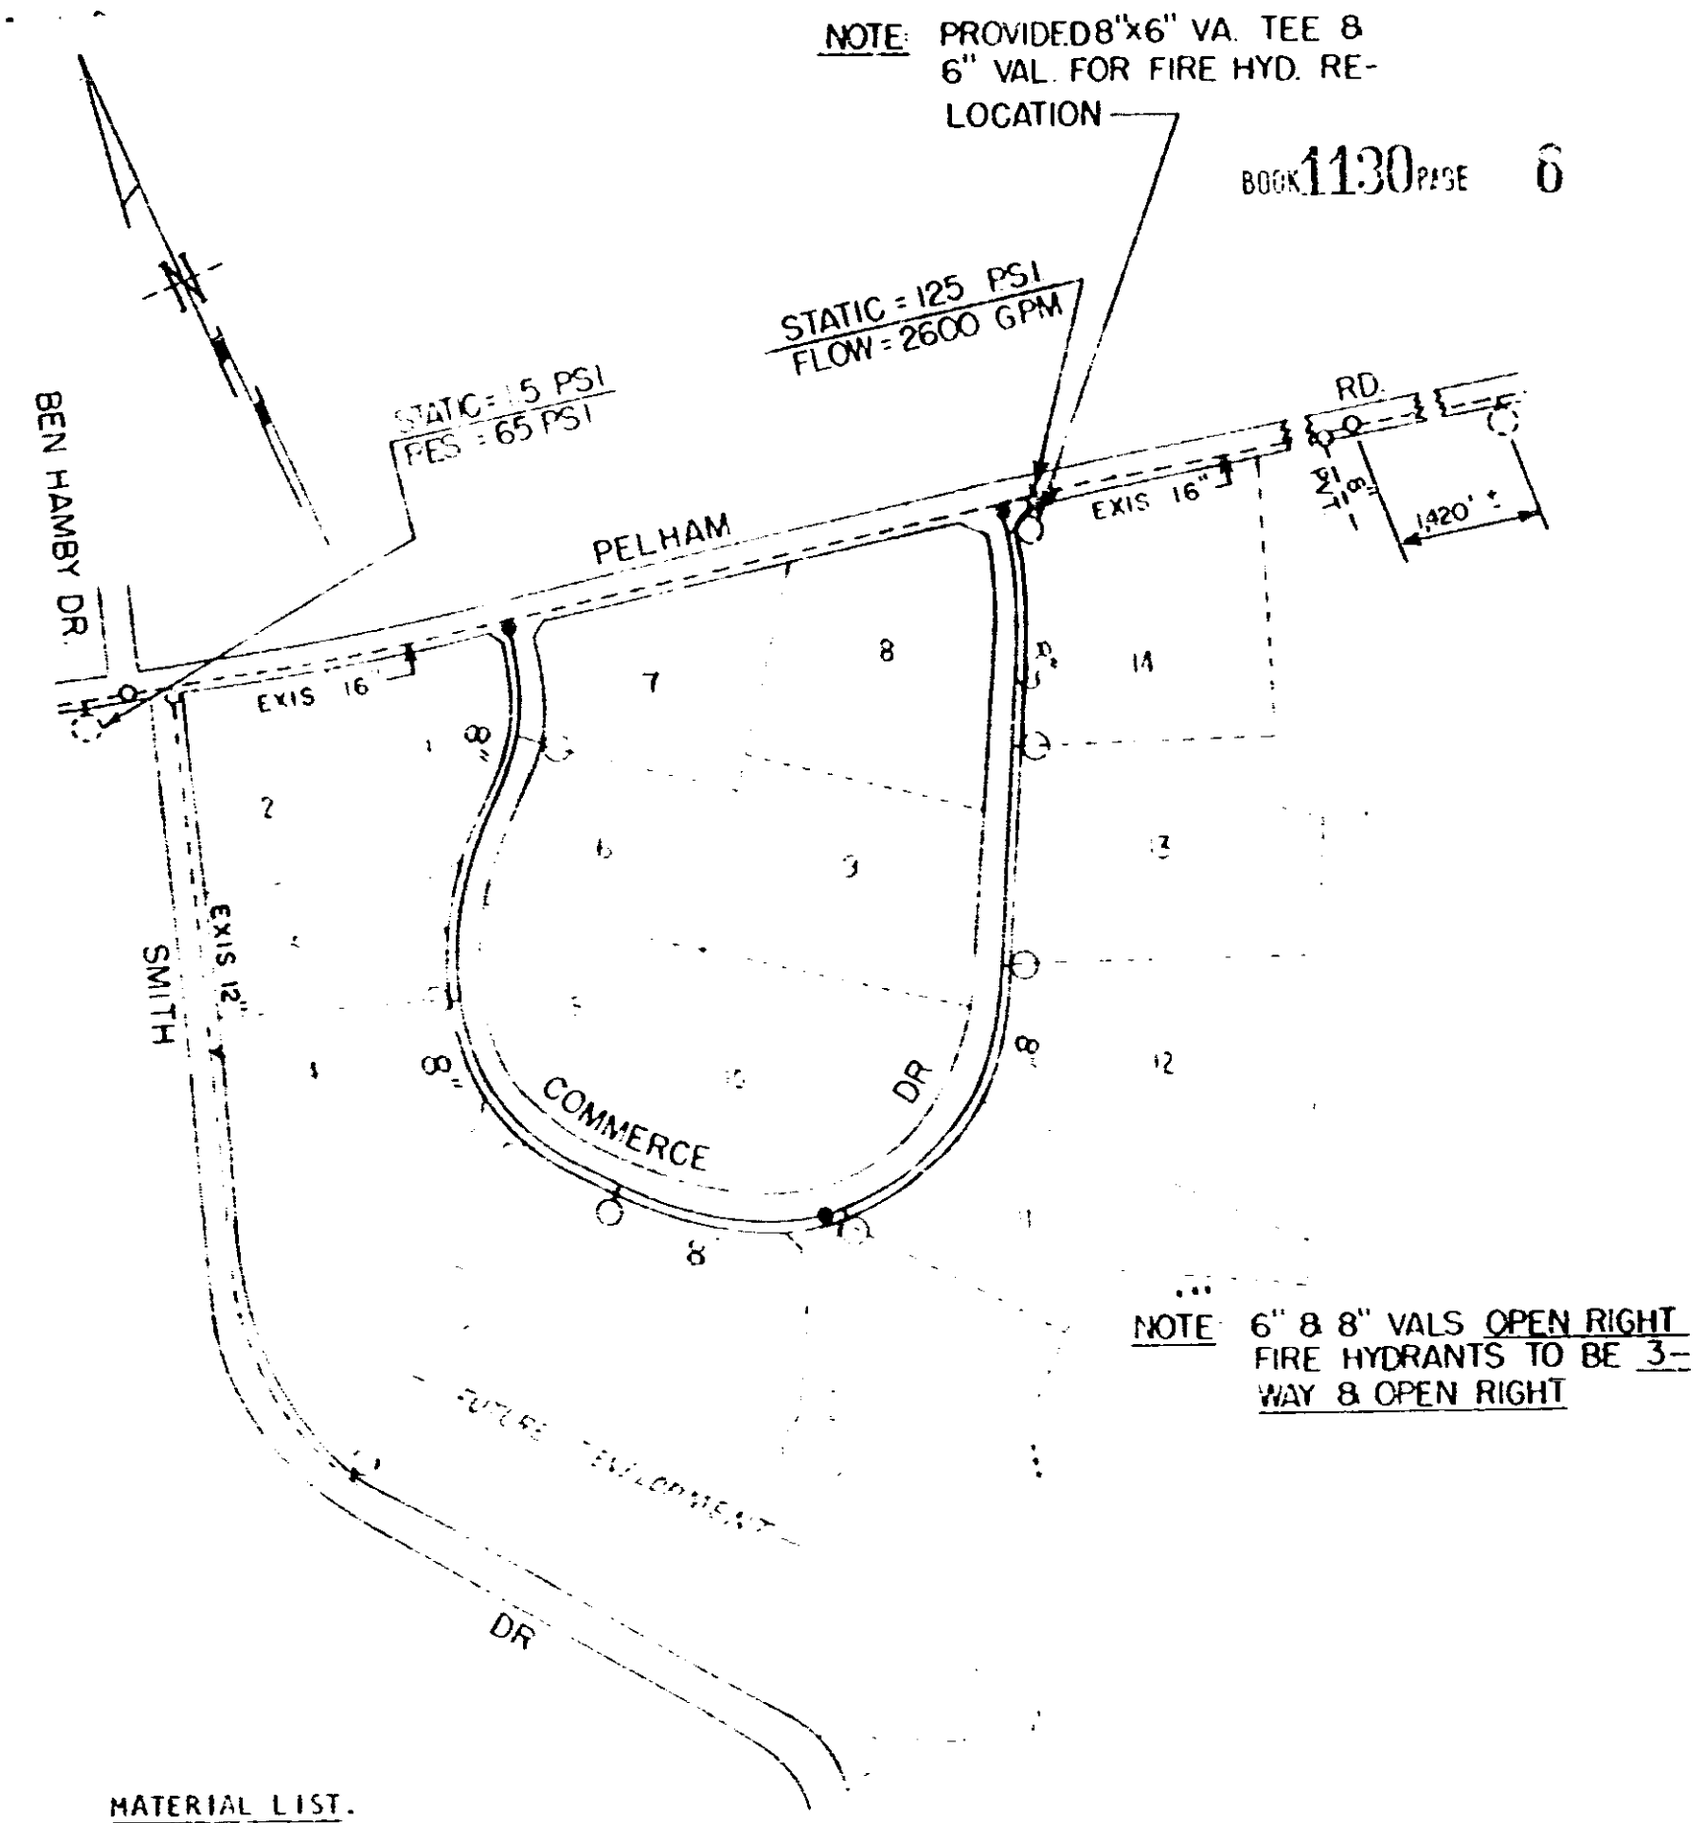


MATERIAL LIST.

| | | |
|---|---|---|
| 8" D. I. Pipe | - | 3,150'± |
| 6" D. I. Pipe | - | 75'± |
| 8" Valves | - | 3 |
| 6" Valves | - | 6 |
| Fire Hydrants | - | 6 |

# COMMERCE CENTER, PH. I

JAN, 1980 SCALE 1" = 400'

Liberty Life Insurance Co.,
a S.C. Corporation

to

Commissioners of Public Works
of the City of Greenville, S. C.
July 10, 1980
(BLK. Book 533 2-1-35)

Rec. July 28, 1980 at 4:23 PM 2662