RECORDED NOV 18 1980
at 4:50 P.M.

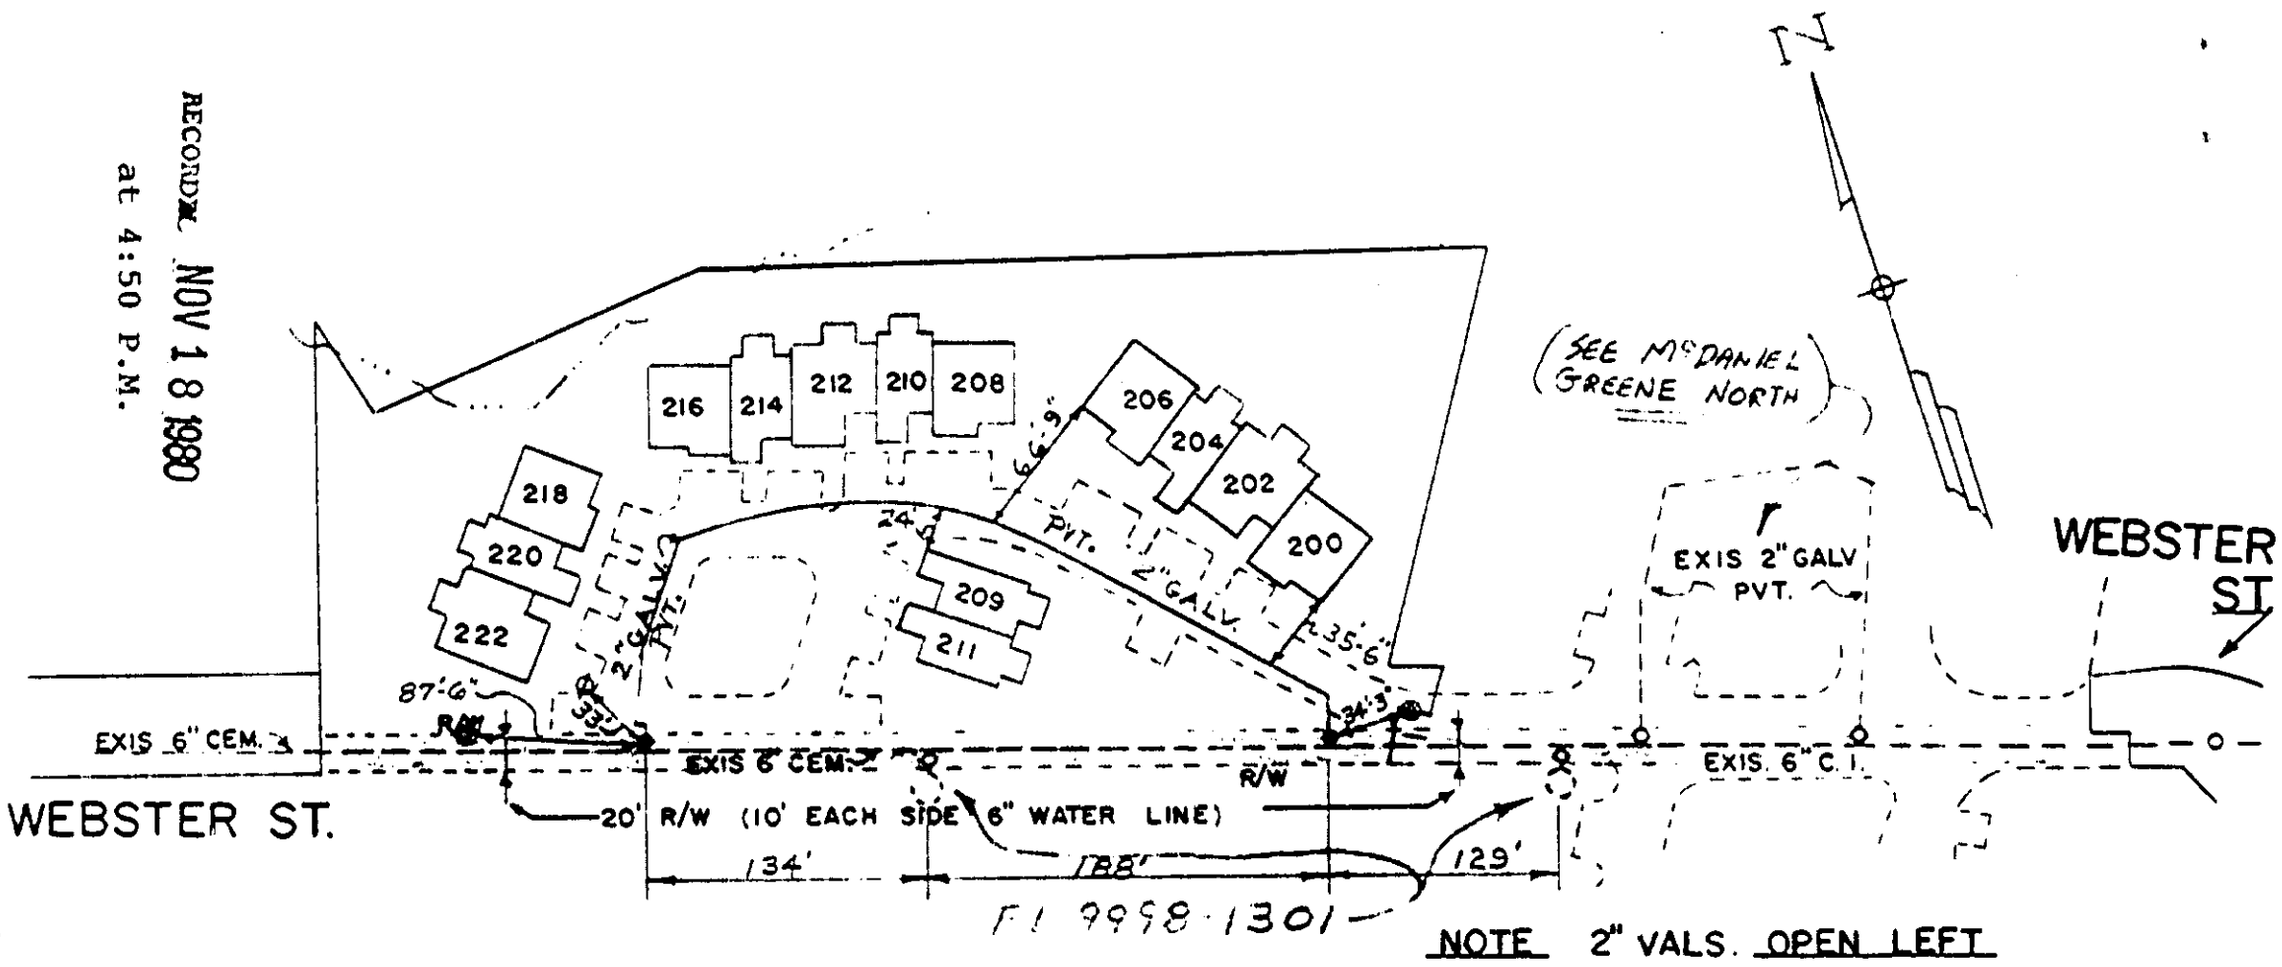

NOTE 2" VALS. OPEN LEFT

McDANIEL GREENE WEST
APRIL, 1980 SCALE 1" = 100'

EASEMENT
McDaniel Associates
A General Partnership
to
Commissioners of Public Works
of the City of Greenville, S. C.
October 27, 1980
(BLK. BOOK 62-3-15)

BOOK 1137 PAGE 509

15460

4328 RV-2