BOOK 1144 PAGE 457

GREENBRIAR SUBDIVISION

"I Hereby" Certify that the Ratio Of Precision of the field survey is 1: as shown and the Area was determined by D.M.D. method of Area Calculation.

S.C.,R.L.S. No. 5287
Duke Power Co.
Charlotte, NC

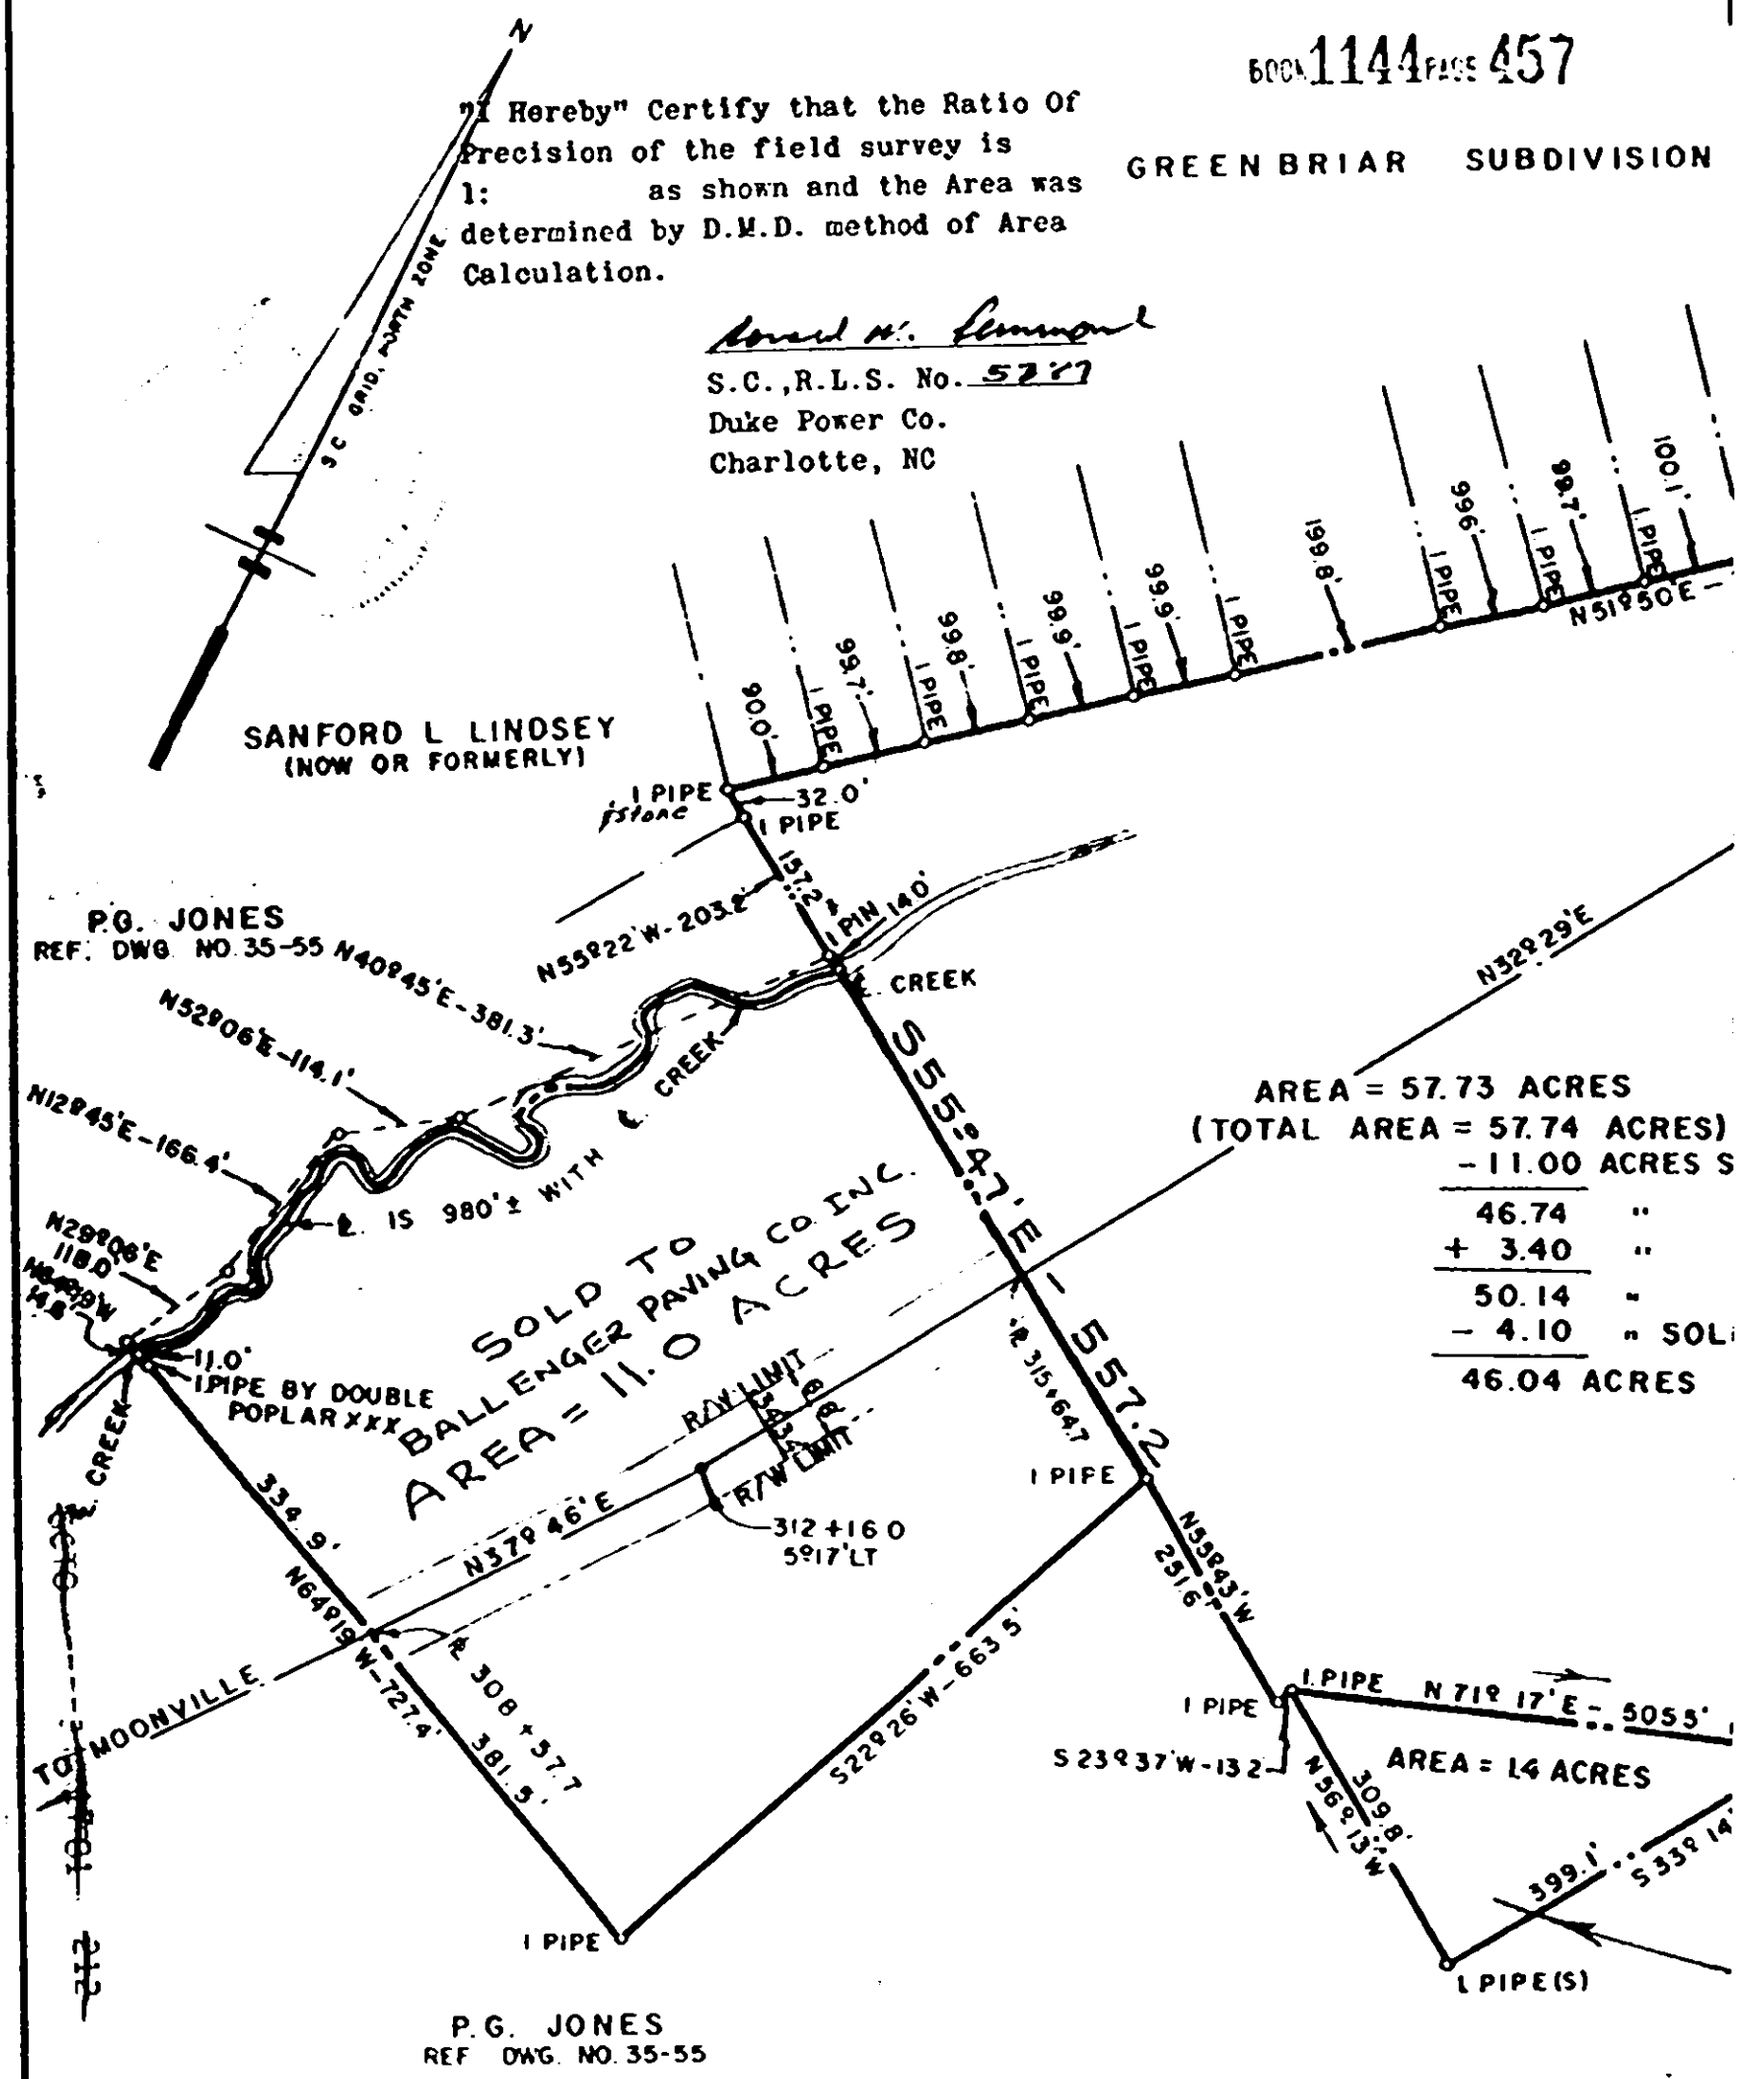

NOTE: LAND EXCHANGE WITH
BALLENGER PAVING CO., INC., E
2-20-80

T.O. NO. 8524

4328 RV.2