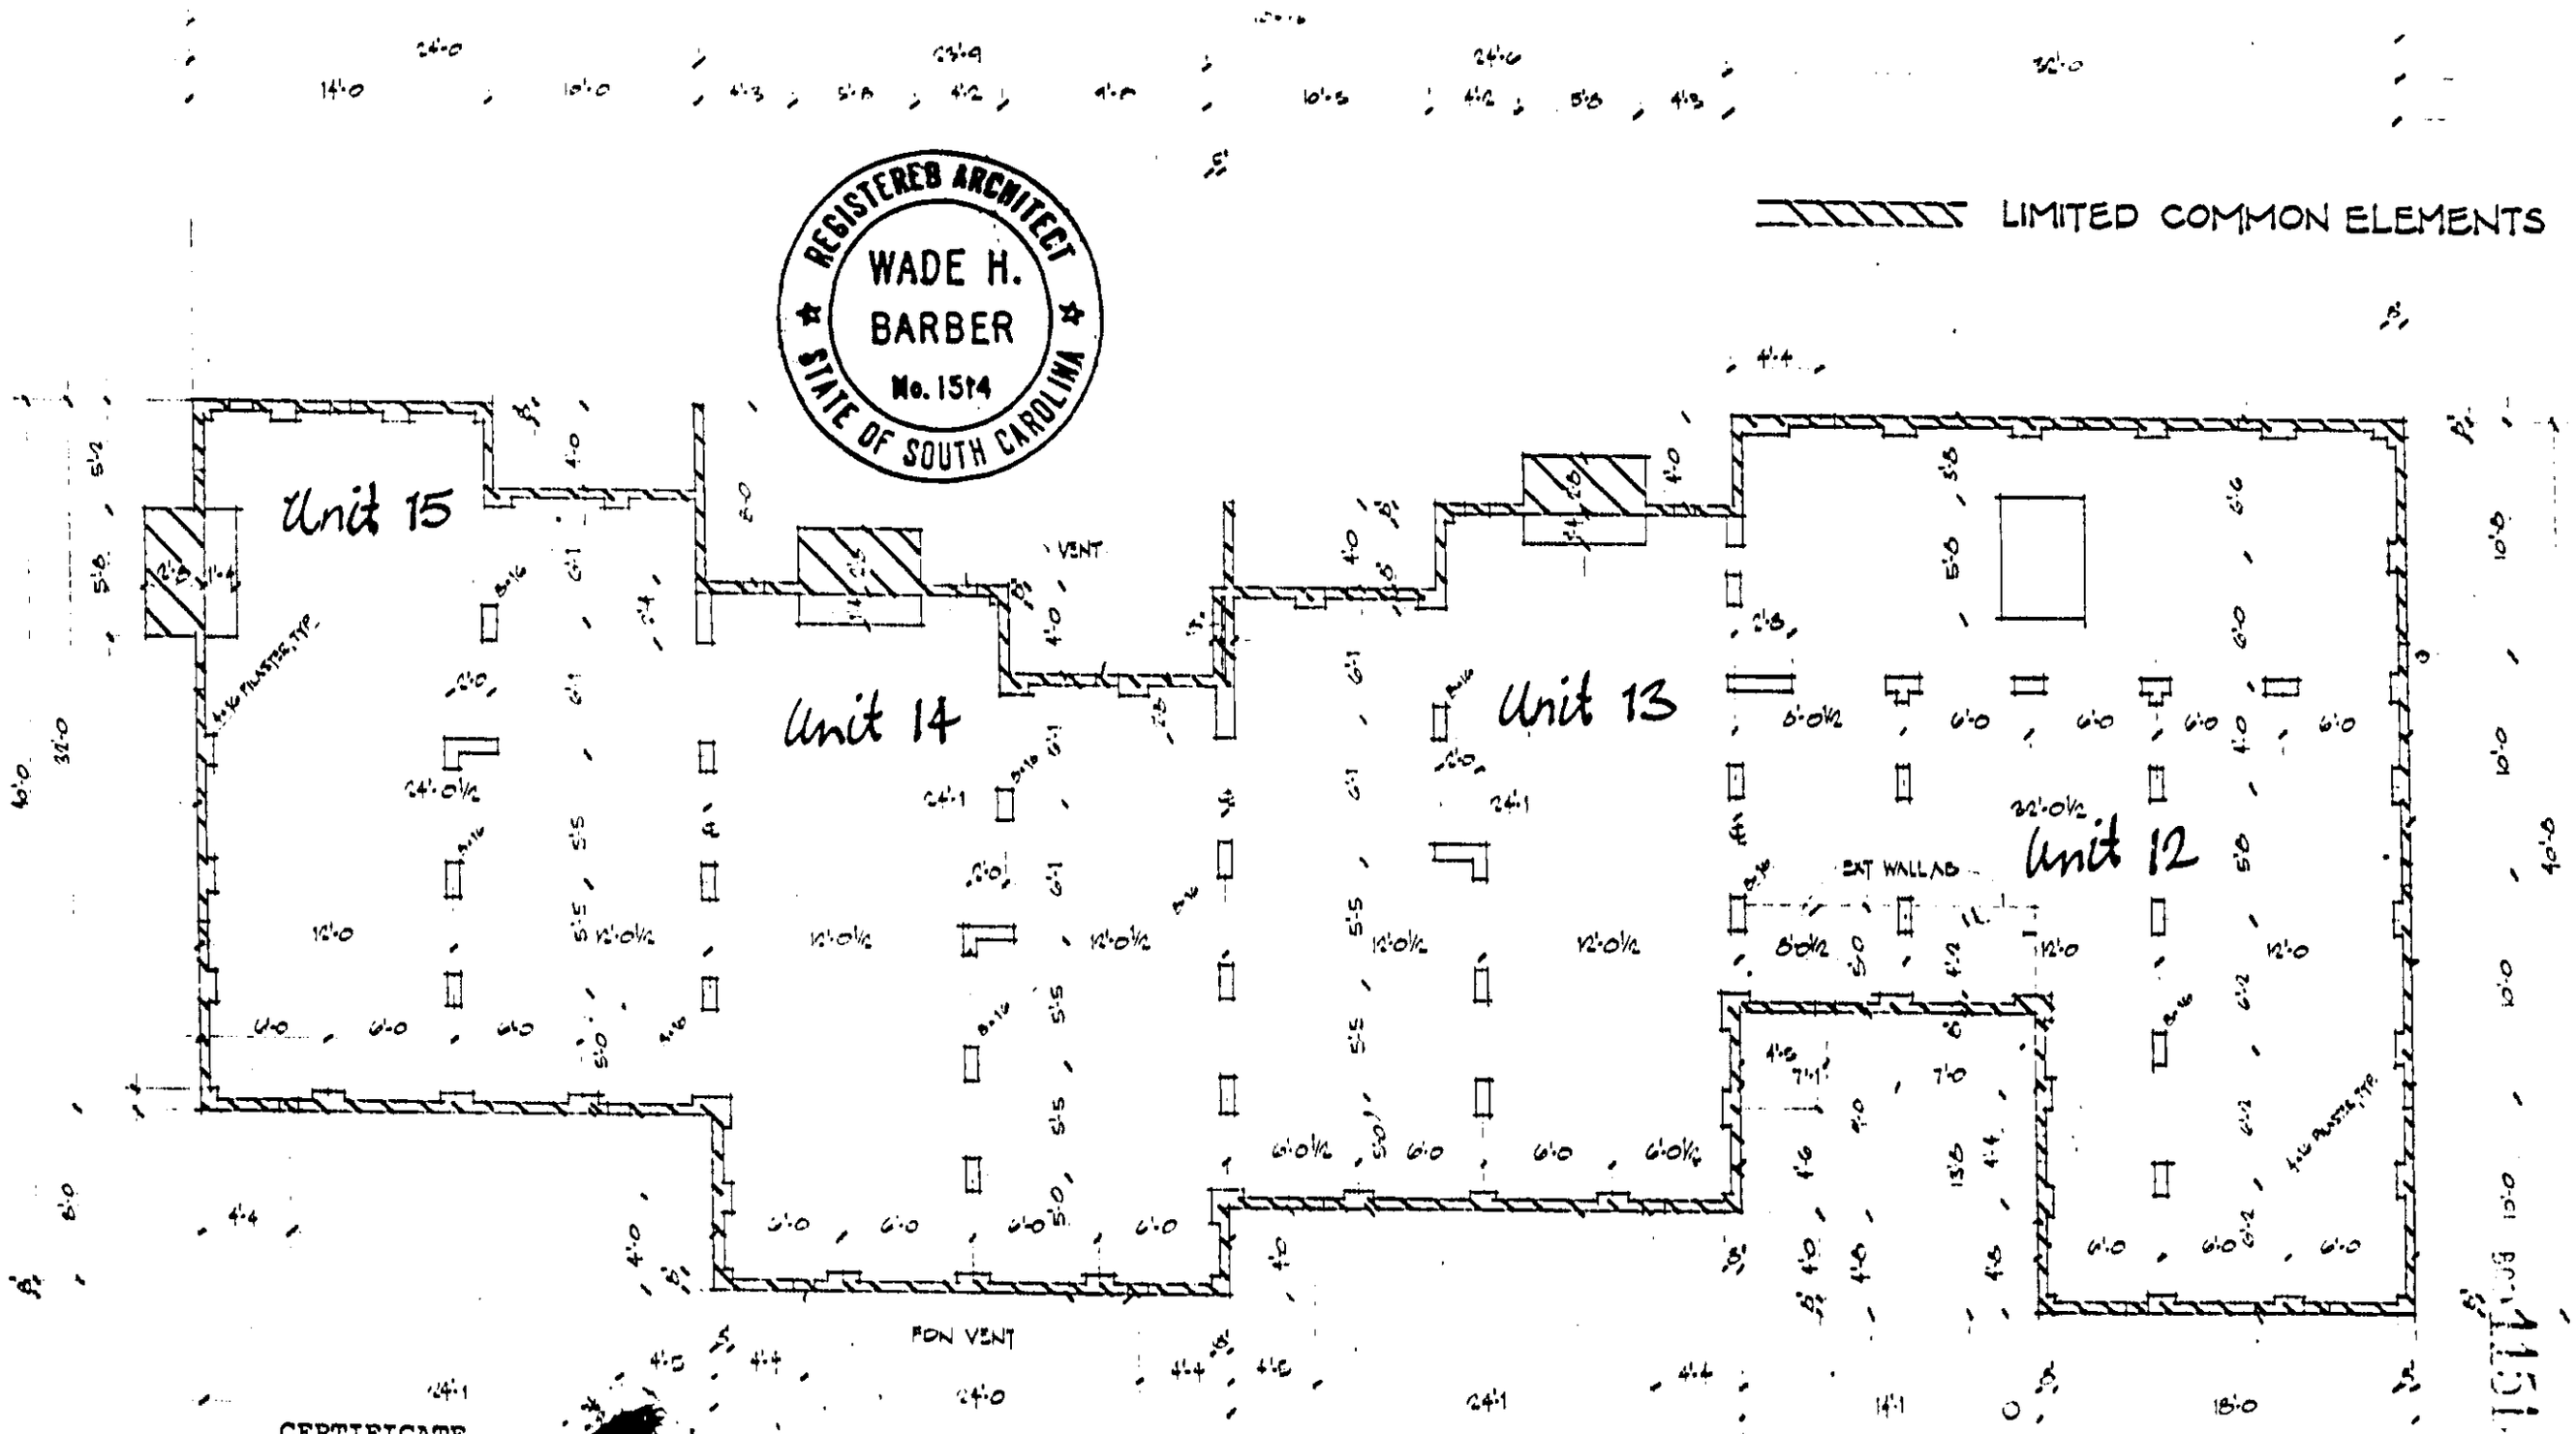

CERTIFICATE

I, Wade H. Barber, do hereby certify that these plans fully depict within reasonable construction tolerances the layout, location, letter identification and dimensions of the buildings and dwellings contained therein. Wade H. Barber

NOTES
1. SIDING
2. FLOOR ELEVATIONS TO BE ESTABLISHED IN FIELD BY OWNER
3. SOIL CAPACITY ASSUMED TO BE 1500 PSF VERIFICATION AS REQD BY OWNER
4. FOOTINGS TO BE 2000PSI CONC. 8" DEEP OR 4" MINIMUM THAN FDN WALL & 6" FDN. IN EACH DIRECTION I.E. FOR 16" FDN TO HAVE 10" DEEP AND 20" FTG. INSTALL (1)#4 @ CONT FTG. IN CENTER OF FILL AREAS INSTALL (2)#4.

FOUNDATION BLDG B
SIDING

4328 RV-2

0 0 8 2