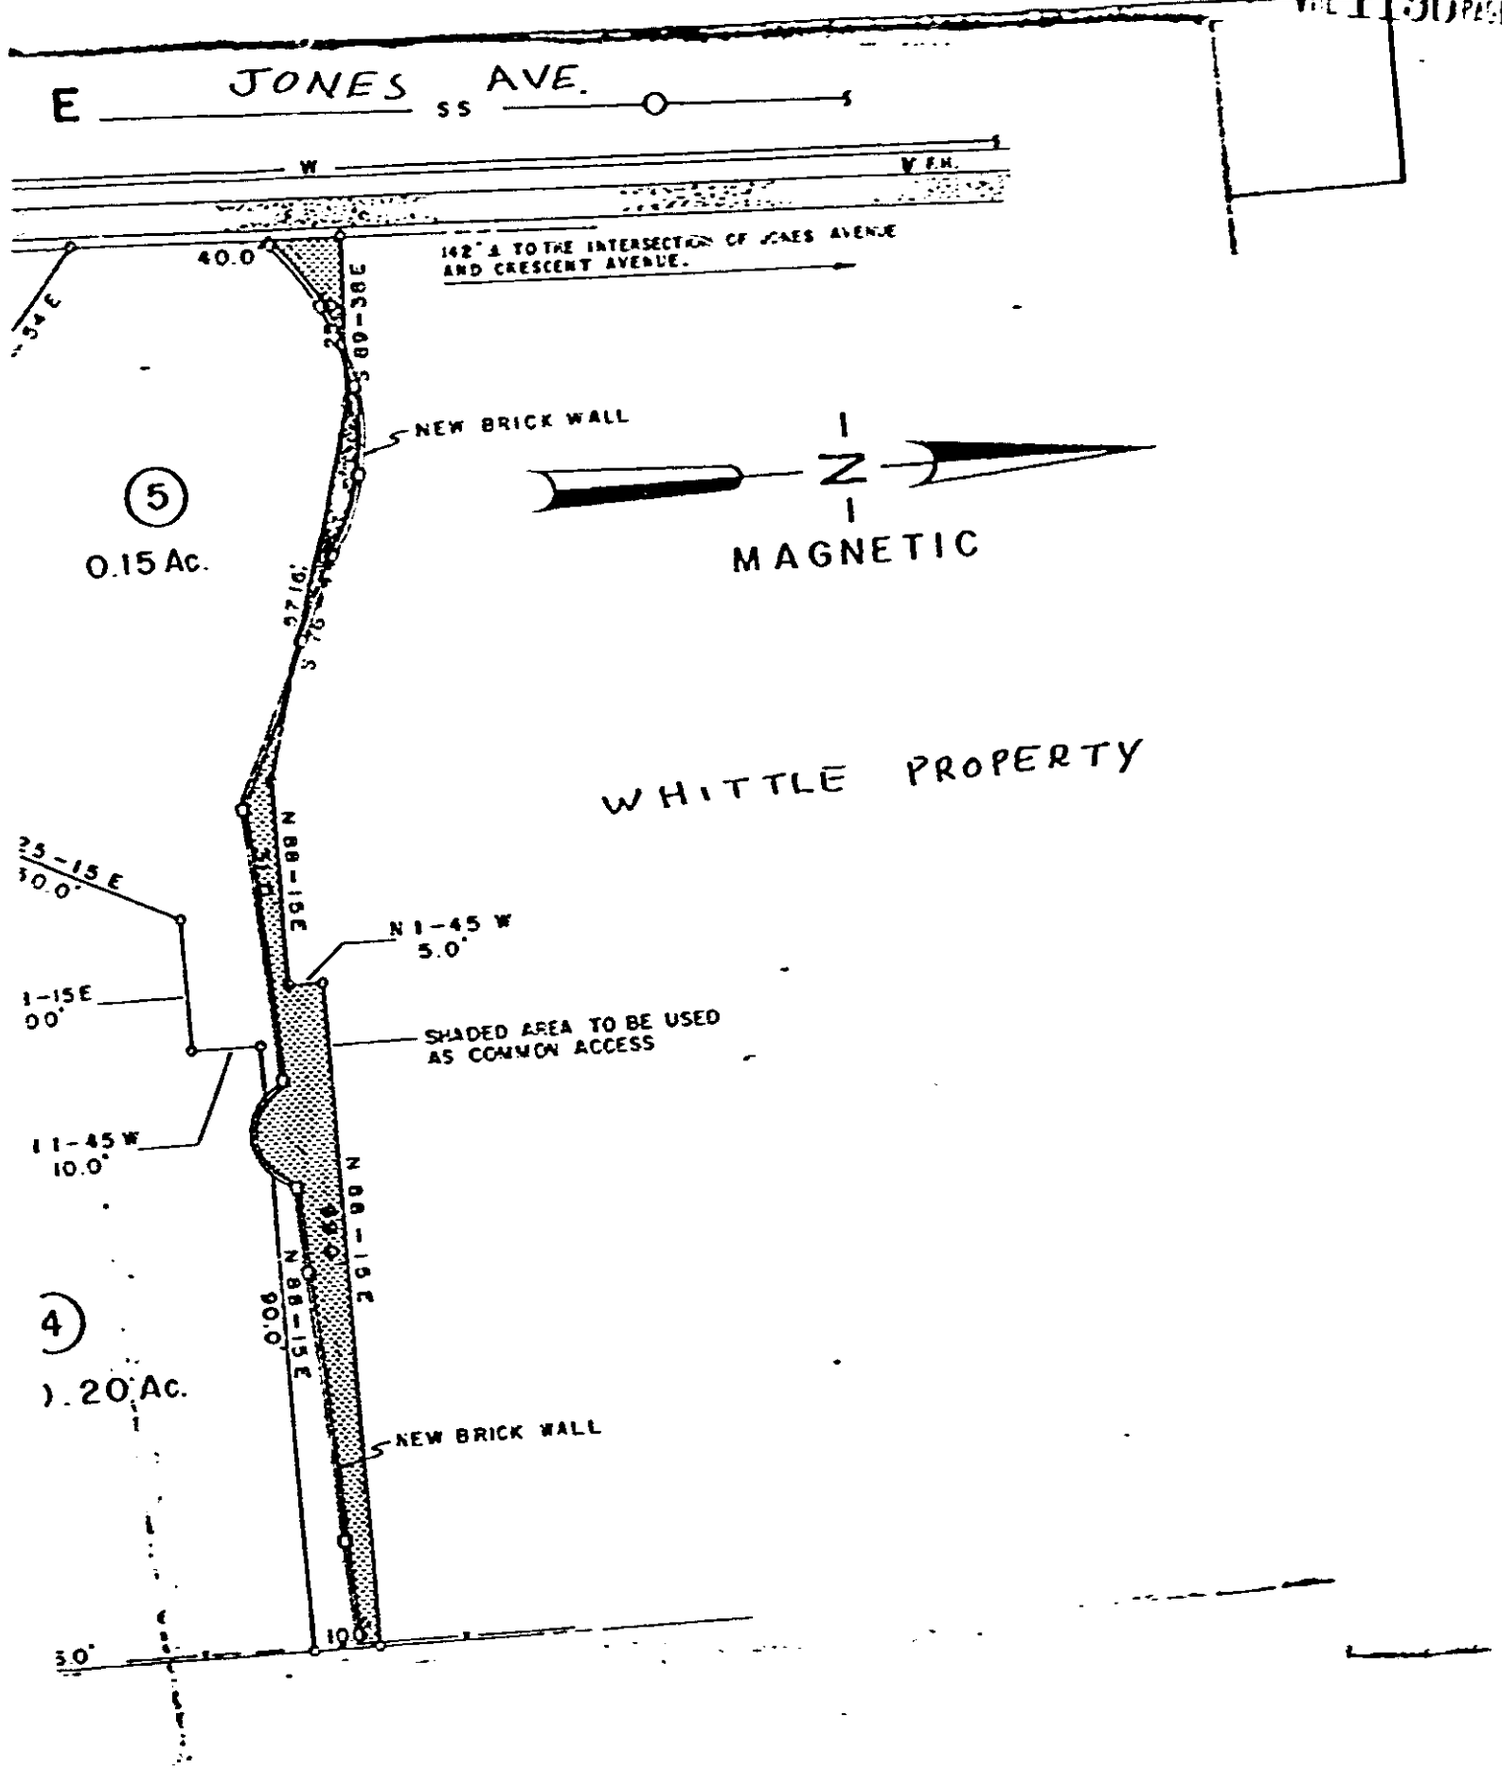

PRINTED
JAN 19
ARBOR ENGINEERING, INC.

NOTES:
1 PLAT REVISED 8 JUNE 82 TO SHOW CHANGES IN

Arbor Engineering
PO BOX 263 GREENV

EXHIBIT "A"

RECORDED SEP 21 1983 at 11:41 A.M.

9511