5080

Z-AN-8287

MB 1205 PAGE 809

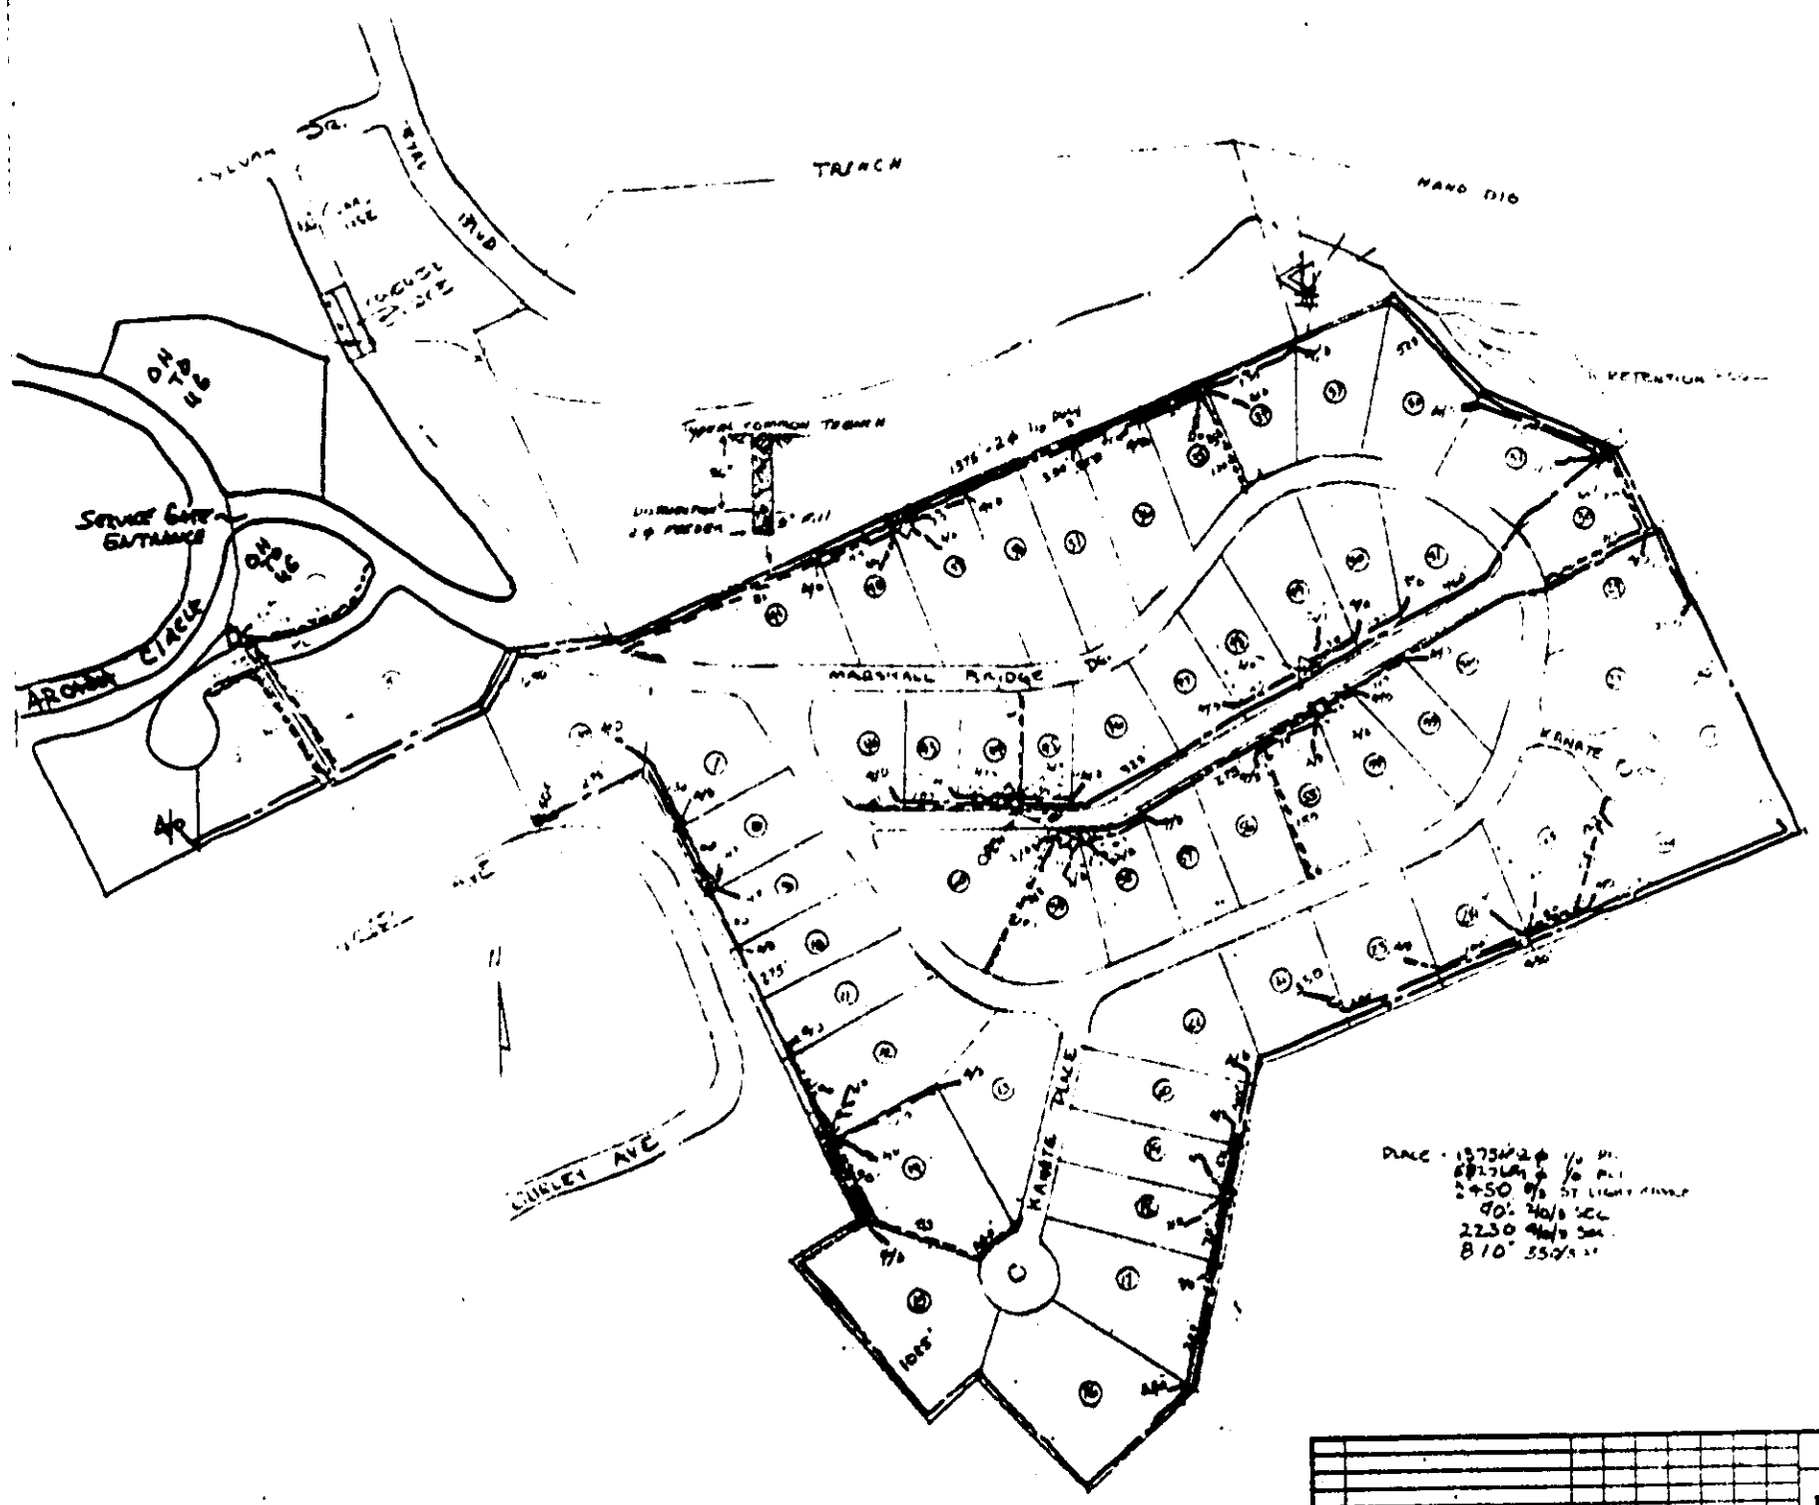

DUKE POWER COMPANY

BROOKSIDE FOREST S/B

DWG. NO. 1" = 100' - JRH - 6/24/83

NO.	REVISIONS						