555

VOL 1222 PAGE 61

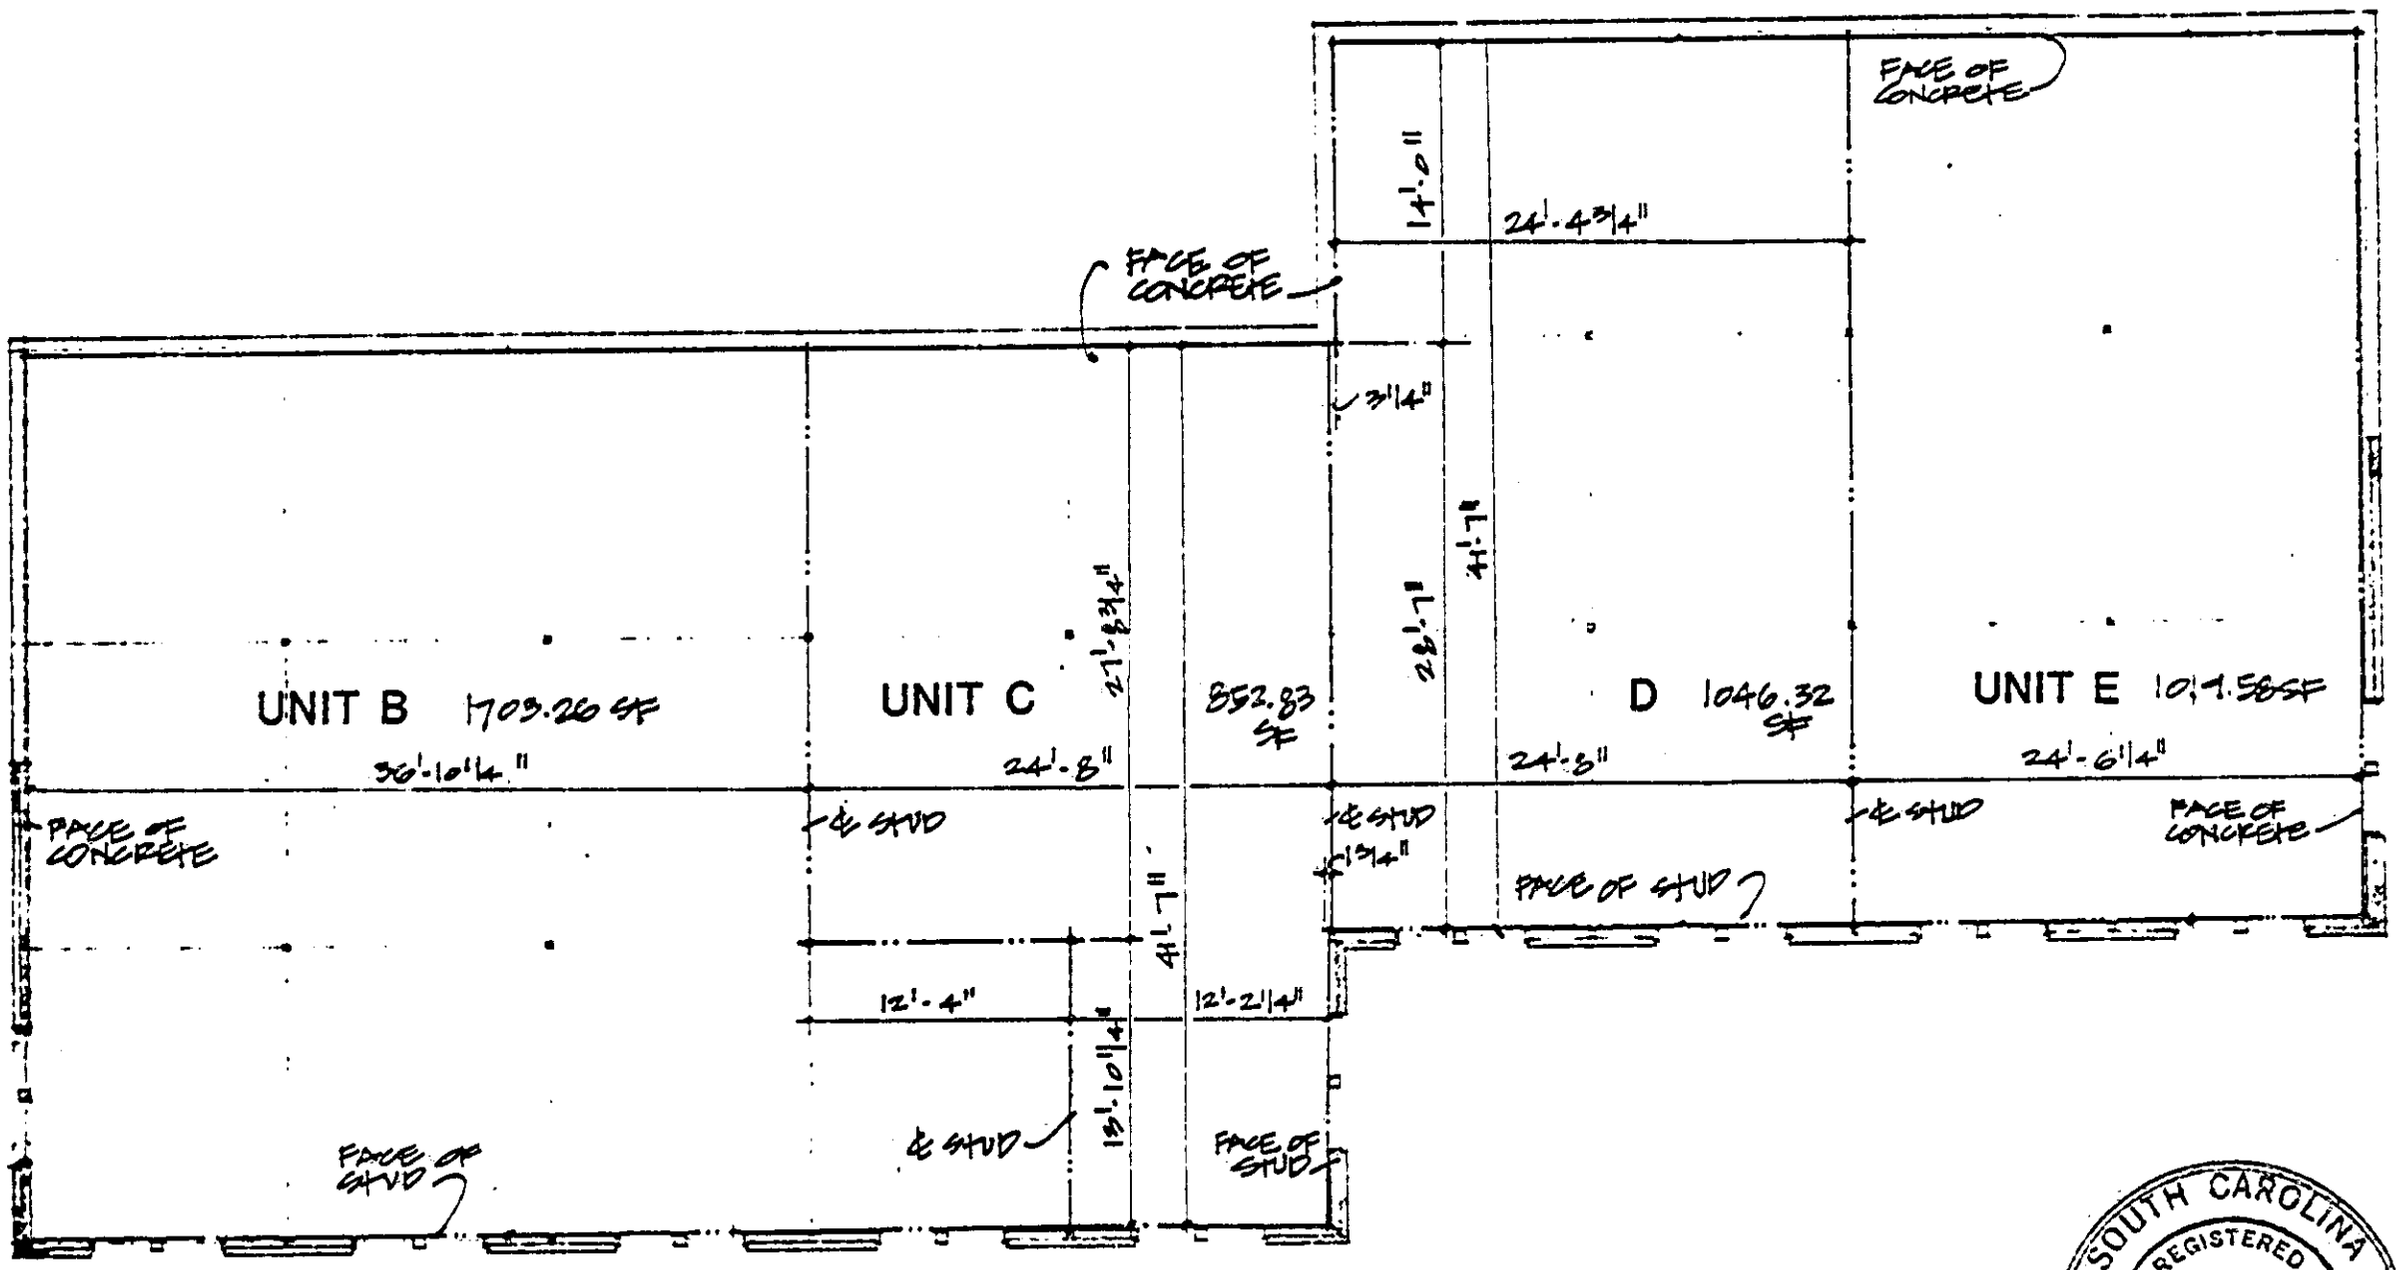

EDGEWOOD MEDICAL PLAZA OFFICE PARK

HORIZONTAL PROPERTY REGIME

LOWER LEVEL

SOUTH CAROLINA
REGISTERED
No. 574
ARCHITECT
F. EARLE GAULDEN