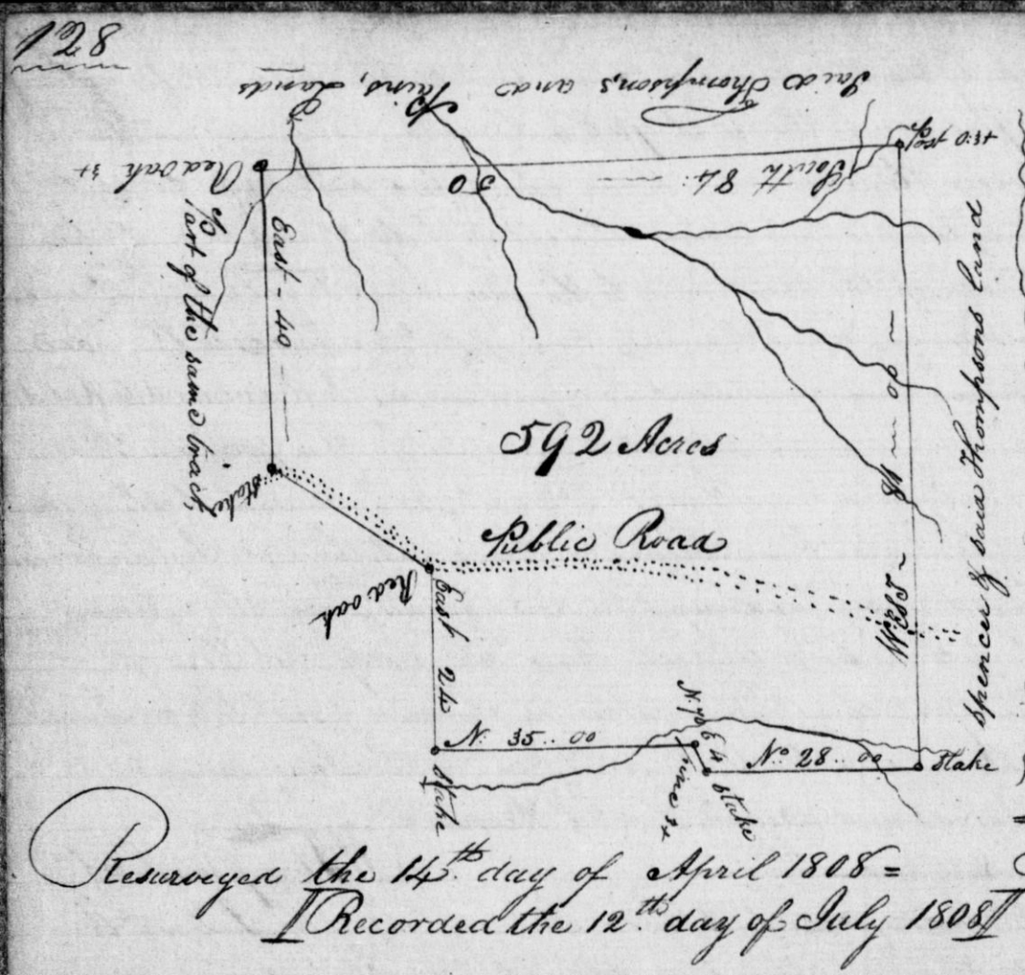
592 Acres
Public Road
Road
East 40
East 40
Spencer & Joshua Thompsons Land
Stake
