


to all and singular the premises within mentioned & Released  
 Given under my hand and seal this 9<sup>th</sup> day of October  
 A.D. 1817 *John H. Goodall J. 2* *Eliza B. Thompson*  
 South Carolina Greenville District. Personally came  
 Baylis John Carl before me the subscribing Justice  
 and being duly sworn maketh Oath that he was present  
 and saw Waddy Thompson Esquire Sign Seal & deliver  
 the within Deed to Francis H. McLeod for the uses and  
 purposes therein mentioned, and that Harvey  
 Cleveland was a subscribing witness with himself  
 to the same. Sworn to & Subscribed Before me this  
 10<sup>th</sup> day of October 1817.

*Geo. M. Carl* C. C. & J. 2 of Office

*D. M. Carl*

(Recorded deed the 10<sup>th</sup> October 1817.)

Laid down by a scale  
 of ten ch. to an inch

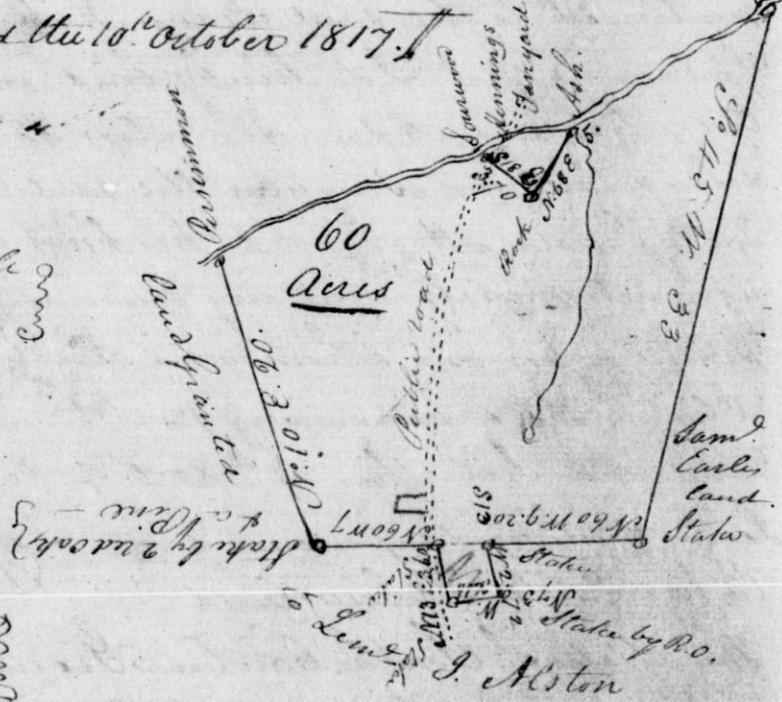

South Carolina  
 Greenville District

I Certify the above Plat of Sixty acres is a true  
 representation of the land sold by Judge Thompson unto  
 Francis H. McLeod lying and being in the district of  
 South Carolina on the West side of a branch of Richland Creek waters  
 of Reedy river, and hath such marks and boundaries as  
 are therein represented. 9<sup>th</sup> October 1817

Recorded the 10<sup>th</sup> of October 1817. *Solm Young D. J.*

101. I David M. Vay Sen<sup>r</sup> formerly of the State of S. Carolina  
 Greenville District, Now of Madison County N. C. do hereby  
 Certify that for a valuable consideration to me in hand made  
 and truly paid by Hugh M. Vay I gave him a Deed to  
 all the land belonging to me which lies in the said Dist.