


chs to the begining bounded by Lands of Josiah Kelgordon Jones  
 Elijah Pike jun and other Land. Together with all and  
 singular the rights members hereditaments and appurtenances  
 to the said premises belonging or in anyway incident or  
 appertaining. To have and to hold all and singular the  
 premises aforesaid unto the said Elijah Pike jun  
 and to his heirs and assigns forever. And I do hereby bind  
 Elijah Pikes Ls deceased heirs executors and administrators  
 to warrant and forever defend all and singular the said  
 premises unto the said Elijah Pike jun and to his heirs  
 and assigns against them and their heirs and every other  
 person lawfully claiming or to claim the same or any part  
 thereof. Witness my hand and seal this 9<sup>th</sup> day of February  
 in the year of our Lord one thousand eight hundred and  
 fifty seven and in the 81<sup>st</sup> year of the Independence of the United  
 States of America. Signed sealed and delivered in the  
 presence of Charles W Roberts & Elijah Pike *Subd*

*John W Grady* Executor of Elijah Pike sen

The State of South Carolina  
 Greenville District Personally appeared before me  
 John W Grady and made oath that he saw Elijah Pike jun  
 Executor of Elijah Pike sen sign seal and deliver the within Deed  
 of conveyance for the use and purposes therein mentioned, and  
 that C W Roberts together with said deponent, was a subscribing  
 witness thereto, Sworn to and subscribed before me this 12<sup>th</sup>  
 day of February 1857 J W Stokes *Subd*

M. G. 4 3  
 Recorded for 18<sup>th</sup> day 1861

*John Grady*

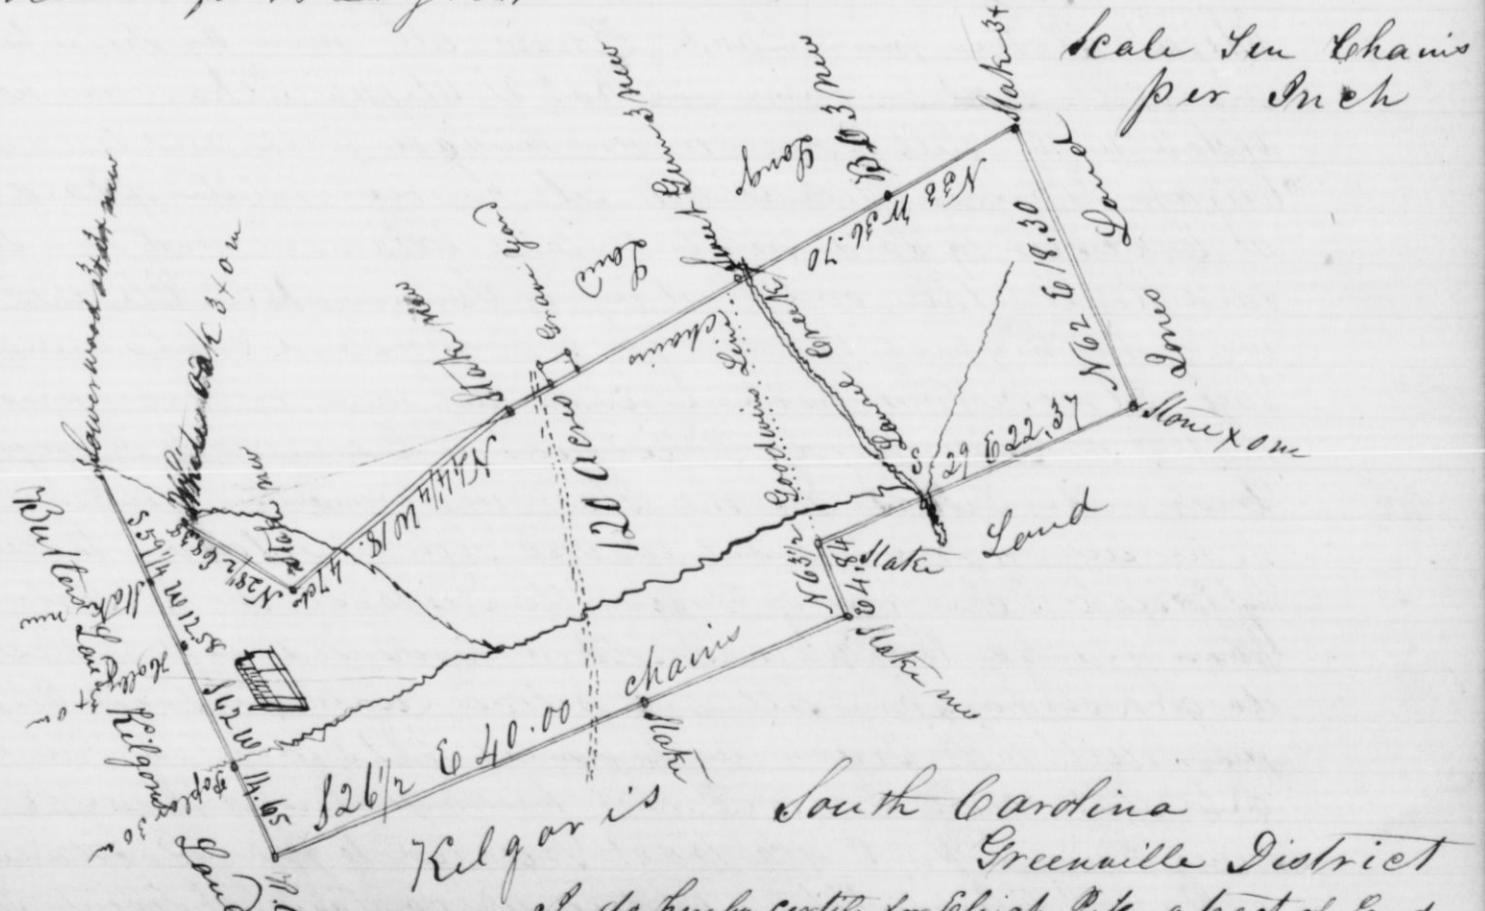

I do hereby certify for Elijah Pike a tract of Land  
 situated in the District and State aforesaid on Laurel Creek water of  
 Reedy River the same being part of a tract granted to Issac Goodwin & a part of  
 tract granted to Elijah Pike sen & containing one hundred and twenty acres  
 having such form & marks as the above represents Surveyed Jan'y 3<sup>d</sup> 1859  
 Recorded for 18<sup>th</sup> day 1861

Wm Taylor J.S.