


South Carolina

Pursuant to a warrant to me
directed under the hand & seal of
John Thomas Esquire Commissioner of
locations in Q.C District North side
of Saluda river bearing date 21st day
of May 1784, I have Admeasured &
laid out unto Alexander Johnson
a tract of land containing six hun-
dred & forty acres situated in the
District aforesaid lying & being on a
small branch Eastward of the Golden
Grove creek bounded on all sides by
vacant lands & hath such shape,
form & marks as the above plat
Representeth -

Surveyed on the 26th day of May 1784

Thomas Luvio. D.

Recorded on the 10th day June 1784.

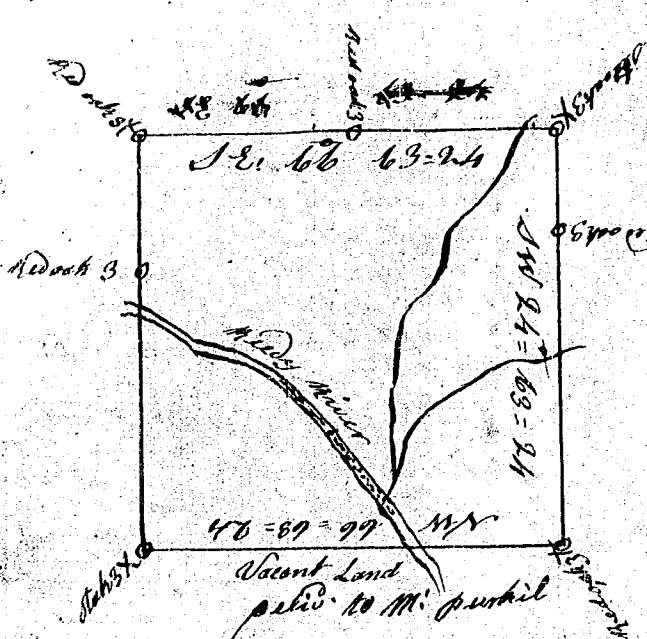


South Carolina

Pursuant to warrant to
me Directed under the hand and Seal of
John Thomas Esq^r Commissioner of Locations
for the district of Ninety-Six North of Saluda
River, I have admeasured and laid out unto
Michael Ferkel four hundred acres of
Land situated lying and being on both
sides of Needy river, Boundary S.S. By land
laid out to Jobes Cook and on the N.E. on
land to John Wison and all other sides -
Vacant, and hath such shape form and
Marks as the above plat represents, certified
by me Thomas Lewis the 4th day of
June 1798.

Thomine Lewis A.S.
10th day of June 1786

Recorded on the 10th day of June 1785.

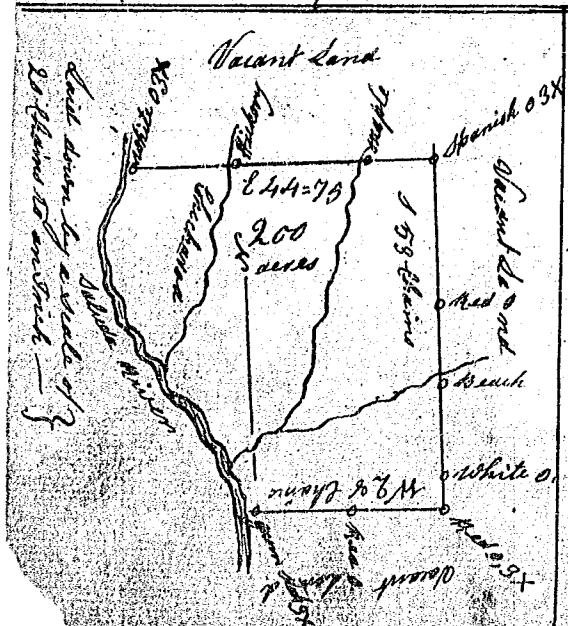

State of South Carolina,

John Thomas Engt. Commissioner of Location dated 25 May
1794 I have admeasured and laid out unto Alexander
McElhenny a Tract of Land Containing Two Hundred
acres situate in Ninety-six District on the N side of
Saluda River Including the Mouth of Chehawee River
Bounding on all other Sides on Abcent Land and hath
such form and Marks as the above Plat Represents

Surveyed the first day of June 1784.

Geo. Salmon D.D.

Recorded 3^d, July 1784.