



(18)

## State of South Carolina

Pursuant to a warrant from John Thomas Esq<sup>r</sup> Commissioner of Locations dated the 21<sup>st</sup> day of May 1784 I have measured and laid out unto Charles Littleton a tract of Four Hundred acres of land situate in Ninety Six District on the waters of Reedy River & ancient Boundary Bounding on the S.E. by land laid out to William Prince and all other sides by Vacant Land and hath such shape and marks as the above plat represents.

Surveyed this 10<sup>th</sup> day of June 1784.

John Bonner Esq.

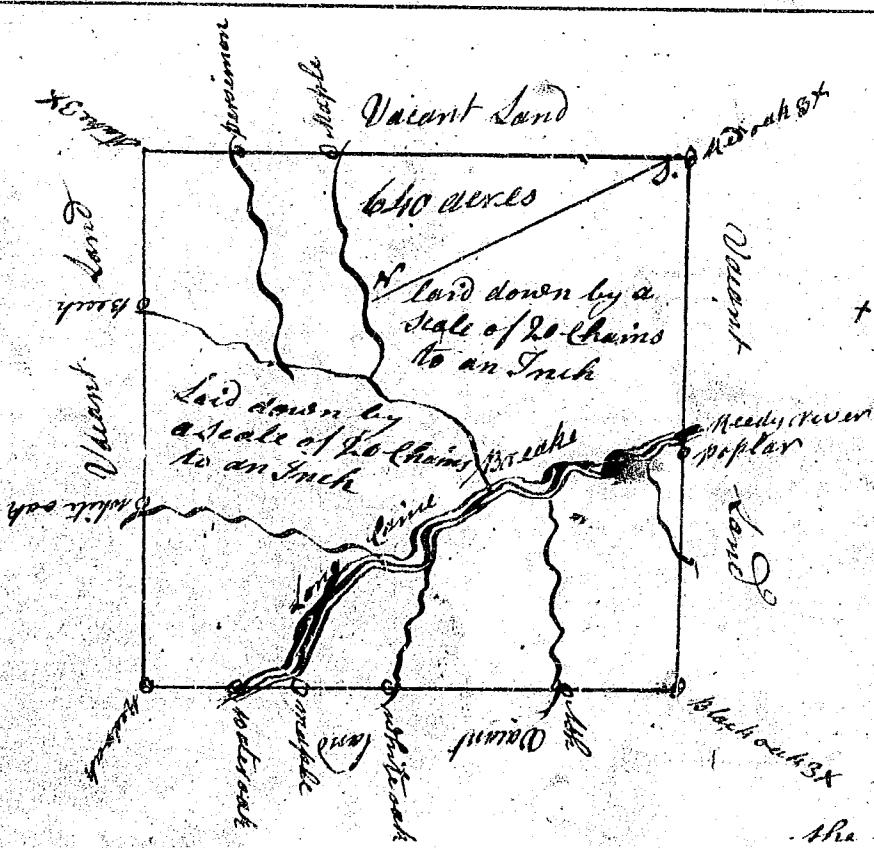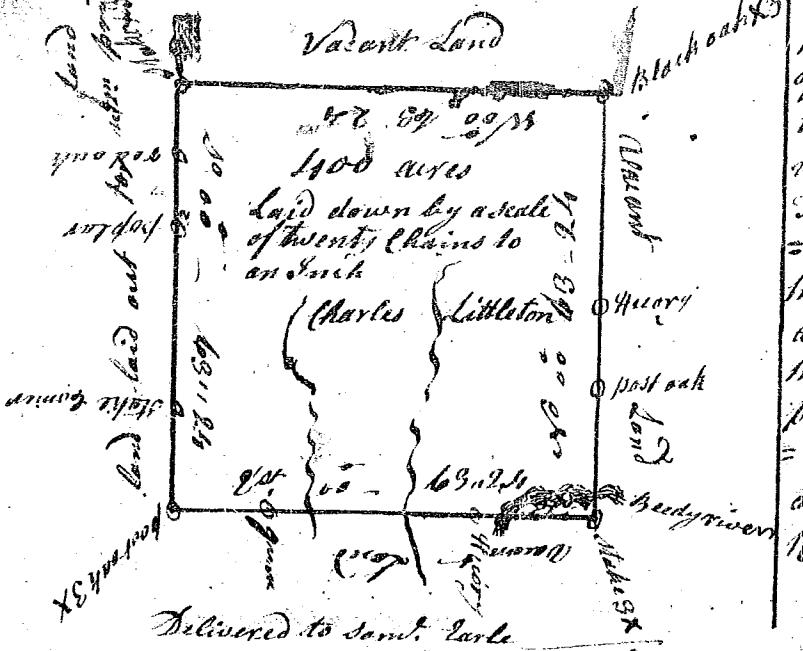

## State of South Carolina


Pursuant to a warrant from John Thomas Esq<sup>r</sup> Commissioner of Locations dated the 21<sup>st</sup> day of May 1784 I have measured and laid out unto William H. Johnson Esq<sup>r</sup> a tract of Six Hundred and forty acres of land situate in Ninety Six district on both sides Reedy river & ancient Boundary including part of the Woods, William Hadirr & Keerby's Improvements Bounding on all sides by Vacant Land and hath such shape & marks as the above plat represents.

The above plat is for record.

Surveyed this 11<sup>th</sup> day of June 1784.

John Bonner Esq.

Delivered to Sam'l Earle

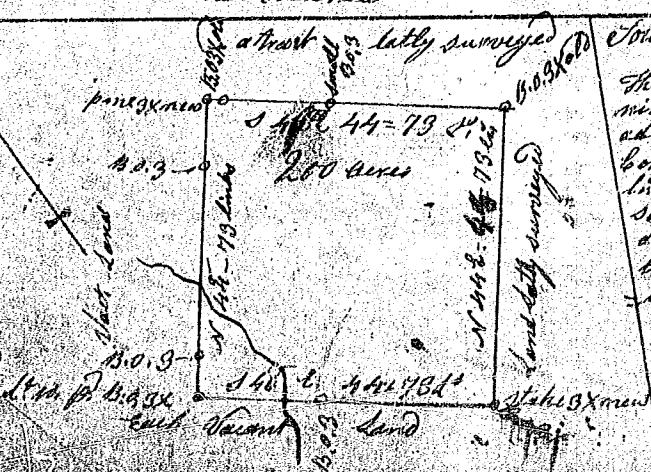

South Carolina pursuant to a warrant from John Thomas Esq<sup>r</sup> Commissioner of Locations in the district of Ninety Six, bearing date the 21<sup>st</sup> day of May 1784 I have measured and laid out unto James King a tract of land containing Two Hundred acres above the ancient boundary line, situated of branches of the golden grotto called Branches of Saluda River Bounding and Bounding to the N.E. partly by a tract of land lately surveyed and partly by Subdivision to the S.E. by an other tract lately surveyed, and all other sides by Vacant Land and hath such shape marks as the above plat represents.

Surveyed the 11<sup>th</sup> day of June 1784.

Recorded the 3<sup>rd</sup> July 1784. John Bonner Esq.