


State of South Carolina.

Pursuant to a warrant from John Thomas Eggar Commissioner of Locations dated the 21st day of May 1784 I have admeasured and laid out unto Joseph Benson a Tract of six hundred and forty acres of land situated on the forks holding grave Creek in Ninety Six District Bounding on all sides by Vacant Land, and hath such shape and Marks as the above plat represent Surveyed this 22nd day of May 1784

Wm. Benson P.D.

Recorded 4th July 1784

Delivered to James Earle -

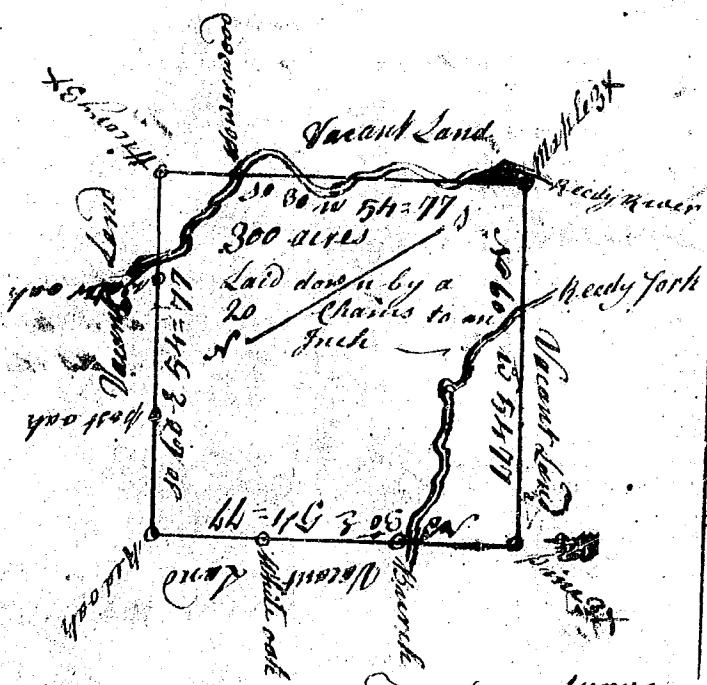

State of South Carolina,

Pursuant to a warrant from John Thomas Eggar Commissioner of Locations, dated the 21st day of May 1784 I have admeasured and laid out unto William Hutcherson a Tract of Land situate in Ninety Six district on the waters of Redy River and the Redy forke to the S.W. of the old Indian Boundary containing three hundred acres Bounding on all sides by Vacant Land, and hath such shape form and Marks as the above plat represents,

Surveyed the 19th day of June 1784

Wm. Benson P.D.

Delivered to James Earle



State of South Carolina

Pursuant to a warrant to me Directed by John Thomas Eggar Commissioner of Locations for the month and dated the same Surveyed and laid out unto James Earle a tract of Land containing 440 acres situate lying and being above the old Indian boundary line between the two rivers and on every side Vacant and hath such shape and marks as the above Plat represents Surveyed & Certified this 16th day of July 1784
Recorded the 17th July 1784 Jas. Earle P.D.
Delivered to himself